IREDELL COUNTY HEALTH DEPARTMENT

STATESVILLE 704-878-5305 MOORESVILLE 704-664-5281

IMPROVEMENT PERMIT / AUTHORIZATION TO CONSTRUCT / OPERATION PERMIT / EXISTING SYSTEM INSPECTION

PERMIT# 81286 PIN# 4756 52 5692 DATE 6-7-99

OWNER OR CONTRACTOR Believers Faith Center PHONE: Business 873 5484 Home

ADDRESS PO Box 1061 Statesville, N.C.

LOCATION Old Mocksville Rd TO Brookview 1/8 mile on left

SUBDIVISION BLOCK / SECTION LOT LOT AREA 4.5 acres SITE CLASS PS DESIGN FLOW 750 L.T.A.R. .35

Septic Tank: 1500 Gallons; STB 797 Date 6-2-99
Pump Tank: Gallons; PT Date
Pump Make: Model Serial No.
Nitrification Field: No Fields 1 Square Feet 2250 Linear Feet 750
No Lines 5 Trench Width 36" Max Trench Bottom Depth 36" Gravel Depth 12"

☑ New System ☐ Repair System Type: I II III IV V VI
System Description: Conv. Gravity
Repair System Description: II II
Maintenance Agreement Required: ☐ Yes ☑ No
☑ Slab ☐ Crawl Space ☐ Basement w/plumbing ☐ Basement wo/plumbing

☐ House/Mod. Home No. Bedrooms
☐ Mobile Home No. Bathrooms
☐ Business No. Employees
☑ Other Church School

Water Supply: ☐ Individual ☑ Public ☐ Community


Comments/Conditions:

Church main Building area


Comments/Conditions:

2 mobile classrooms + Gym
Total 60 Students + 4 Teachers

INITIAL SITE SKETCH

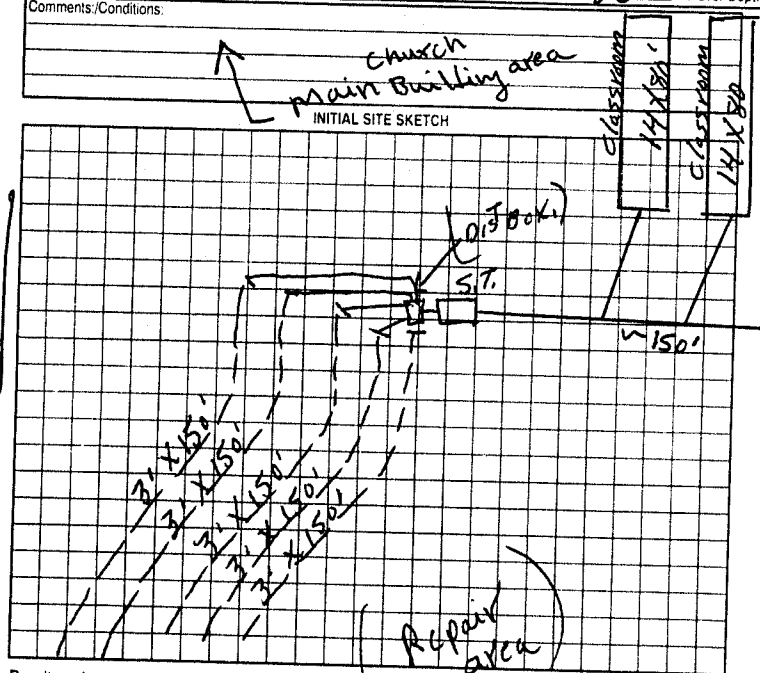

AS BUILT SKETCH

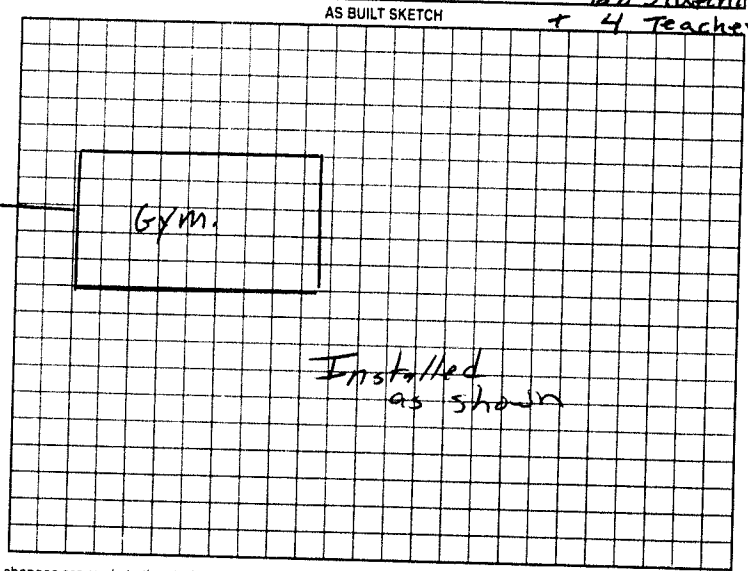

Permit can be suspended or revoked if any false information is supplied toward securing the permit/any unauthorized changes are made to the site/any unauthorized changes are made in the installation of the system. Improvement Permit with plat valid without expiration. Improvement Permit with site plan valid for sixty months. Authorization to Construct is valid for a period equal to that of Improvement Permit – not to exceed sixty months.

Signed: X. Pat Moore date

Improvement Permit by: P.C. Moore date 6-7-99

Authorization to Construct by: P.C. Moore date 6-7-99

Installed by: James Hudler

Operation Permit by: Mary C. Ost RS date 7-7-99

Existing System Inspection by: date

HEALTH DEPT COPY WHITE OWNER COPY (FINAL) YELLOW OWNER COPY (INITIAL) PINK