.92

IREDELL COUNTY HEALTH DEPARTMENT

STATESVILLE 704-878-5305 MOORESVILLE 704-664-5281

IMPROVEMENT PERMIT / CERTIFICATE OF COMPLETION / OPERATION PERMIT / EXISTING SYSTEM INSPECTION

PROPERTY DESCRIPTION NO. 69199 DATE 8-28-97 TAX MAP NO. 4756529593 Watershed: ☐ Yes ☐ No

OWNER OR CONTRACTOR Believers Faith Center PHONE: Business 8035484 Home

ADDRESS PO Box 1061 Sta

LOCATION Old Mocksville Rd TL Brookview 1/4mi 1st Lot

SUBDIVISION BLOCK / SECTION LOT LOT AREA 4.3 acres SITE CLASS. PS DESIGN FLOW 500 L.T.A.R. .4

Septic Tank: EX-1000 Gallons; STB Date

Pump Tank: Gallons; PT Date

Pump Make: Model Serial No.

Nitrification Field: No Fields 1 Square Feet 600 Linear Feet 200

No Lines 5 Trench Width 36" Max Trench Bottom Depth 36" Gravel Depth 12"

☐ New System ☑ Repair System Type: I, II, III, IV, V, VI

System Description:

Repair System Description Conv. Gravity

Maintenance Agreement Required: ☐ Yes ☐ No

☐ House/Mod. Home No. Bedrooms

☐ Mobile Home No. Bathrooms

☐ Business No. Employees

☑ Other Modular School Bldg → 750 Person

☐ Slab ☑ Crawl Space ☐ Basement w/plumbing ☐ Basement wo/plumbing

Water Supply:
☐ Individual
☐ Community
☑ Public


Comments:

Adding 200' TO Existing system & consisting of 1000 gal ST. 300 Line Installed 9-14-92 under

Comments:

Believers Faith center . orisinal System design for 360 gal/da

INITIAL SITE SKETCH

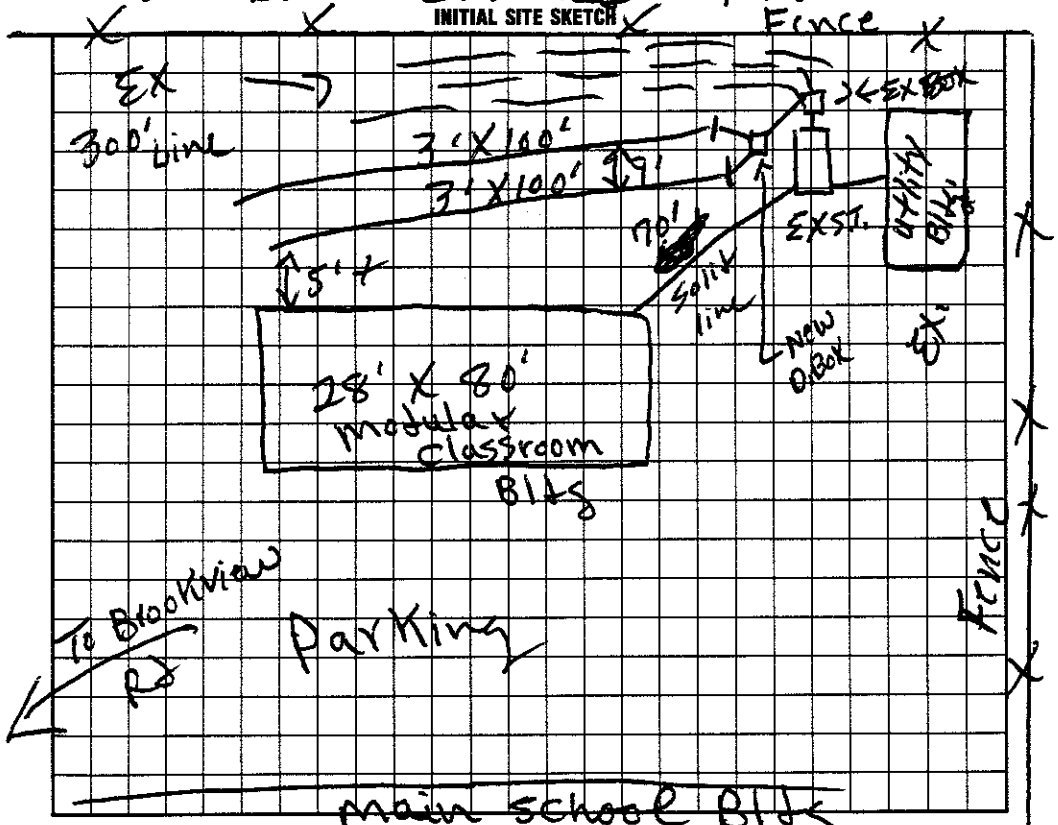

AS BUILT SKETCH

Same as initial sketch

I understand that this permit can be suspended or revoked if any false information is supplied toward securing the permit/any unauthorized changes are made to the site/any unauthorized changes are made in the installation of the system. Improvement Permit is valid for 60 months from date of issuance.

Signed:

Improvement Permit by: R. C. Moore date 8-28-97

Authorization Existing System Inspection by: R. C. Moore date 8-28-97

Installed by: James Hutler

Certificate of Completion by: date

Operation Permit by: R. C. Moore date 8-28-9

to county

HEALTH DEPT. COPY: WHITE INSPECTION COPY (FINAL): GREEN OWNER COPY (FINAL): YELLOW INSPECTION COPY (INITIAL): PINK OWNER COPY (INITIAL): GOLD