4756-52-9593 .93 3:30

IREDELL COUNTY HEALTH DEPARTMENT

STATESVILLE 704-878-5305 MOORESVILLE 704-664-5281

IMPROVEMENT PERMIT / CERTIFICATE OF COMPLETION / OPERATION PERMIT / EXISTING SYSTEM INSPECTION

PROPERTY DESCRIPTION NO. 20875 DATE 4-21-95 TAX MAP NO. 10 B-A-18 Watershed: ☐ Yes ☒ No

OWNER OR CONTRACTOR Believer's Faith Center PHONE: Business 873-5464 Home

ADDRESS Po Box 1061 Sta N.C.

LOCATION 64E TL old mocksville Rd TL Brookview Rd 1/4mi left

SUBDIVISION 1500 BLOCK / SECTION LOT LOT AREA 20 acres SITE CLASS. PS DESIGN FLOW 800 gal/day L.T.A.R. .35

Septic Tank: ~~1000~~ Gallons; STB 794 Date 4-9-95

Pump Tank: Gallons; PT Date

Pump Make: Model Serial No.

Nitrification Field: No Fields 1 Square Feet 2250 Linear Feet 750

No Lines 8 Trench Width 36" Max Trench Bottom Depth 36" Gravel Depth 12"

☒ New System ☐ Repair System Type: I, II, ☉ III, IV, V, VI

System Description: Conv. Gravity out 480

Repair System Description: " "

Maintenance Agreement Required: ☐ Yes ☒ No

☐ House/Mod. Home No. Bedrooms

☐ Mobile Home No. Bathrooms

☐ Business No. Employees

☒ Other Christian School 80 students


☒ Slab ☐ Crawl Space ☐ Basement w/plumbing ☐ Basement wo/plumbing

Water Supply:
☐ Individual
☐ Community
☒ Public


Comments: Repair area is To west off Drainfield in large field

Comments: System was not connected To Building at Time of This inspection

INITIAL SITE SKETCH

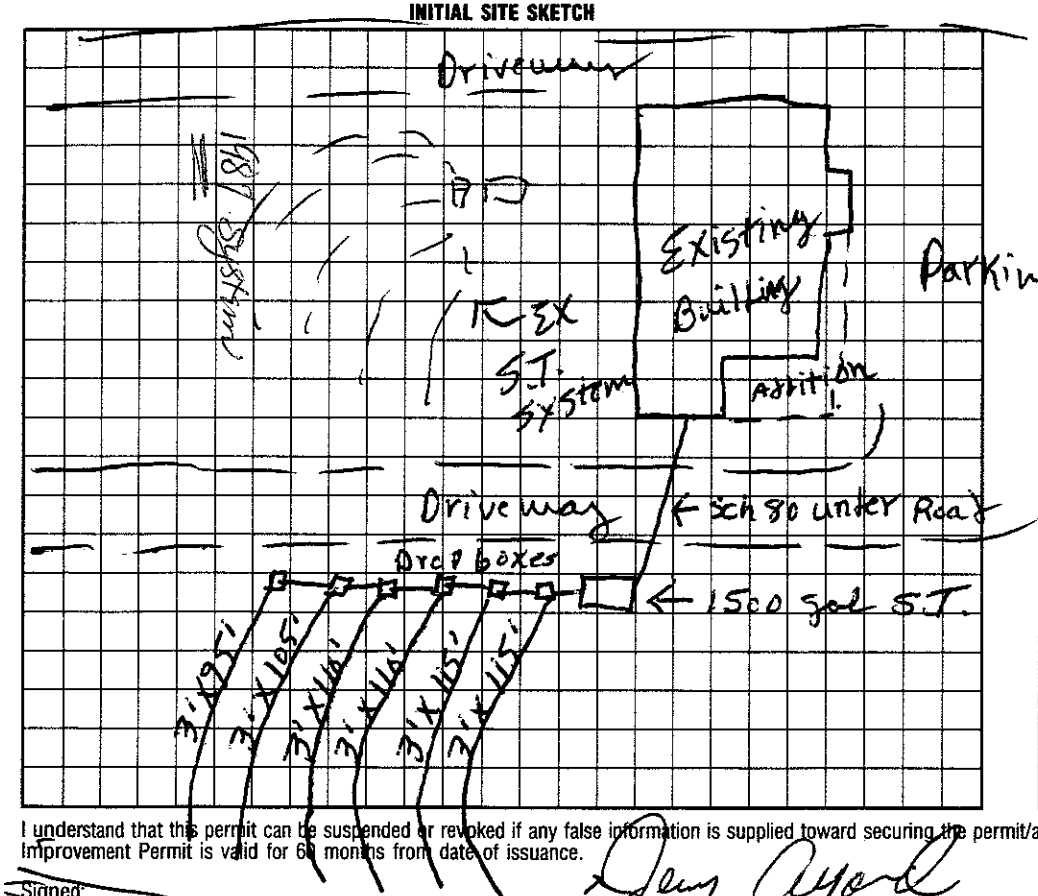

AS BUILT SKETCH

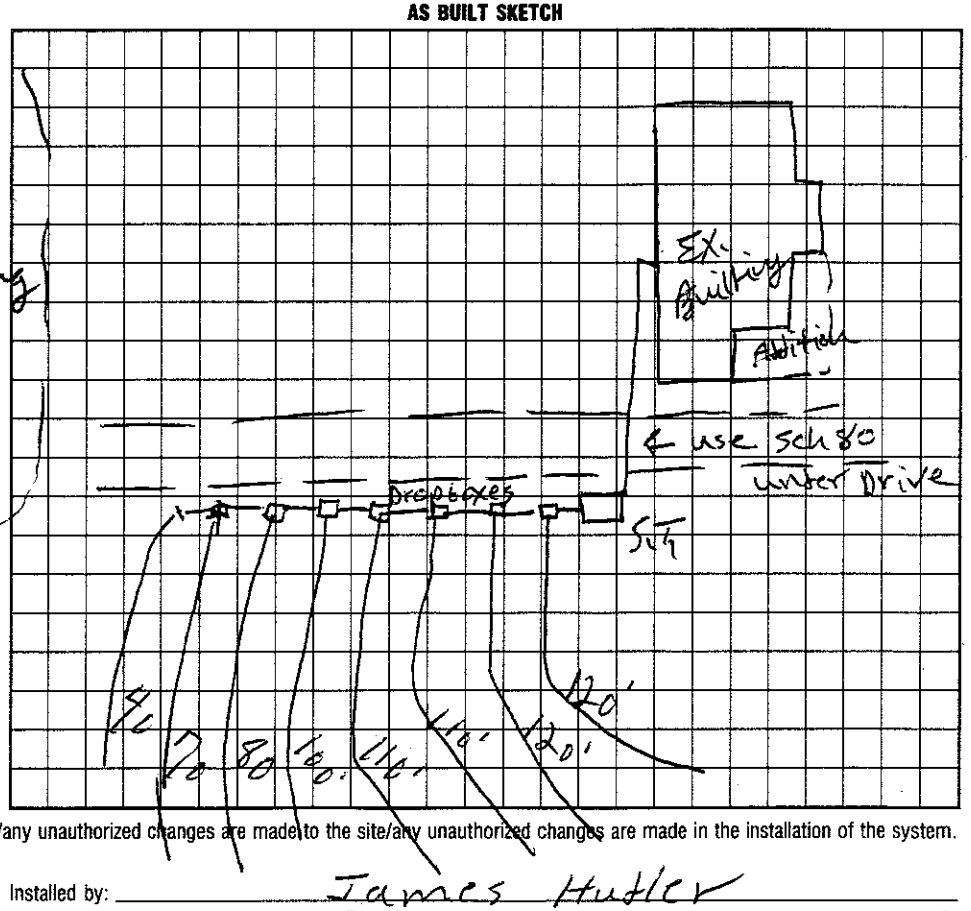

I understand that this permit can be suspended or revoked if any false information is supplied toward securing the permit/any unauthorized changes are made to the site/any unauthorized changes are made in the installation of the system. Improvement Permit is valid for 60 months from date of issuance.

Signed: Jerry Ayers

Improvement Permit by: F.C. Moore date 4-21-95

Existing System Inspection by: Drainage date

Installed by: James Hutler

Certificate of Completion by: F. C. Moore date 6-16-95

Operation Permit by: date

HEALTH DEPT. COPY: WHITE INSPECTION COPY (FINAL): GREEN OWNER COPY (FINAL): YELLOW INSPECTION COPY (INITIAL): PINK OWNER COPY (INITIAL): GOLD

Repair area