IREDELL COUNTY HEALTH DEPARTMENT

Statesville Office (704) 878-5305 Mooresville Office (704) 660-3625 PERMIT # 206679

IMPROVEMENT PERMIT / AUTHORIZATION TO CONSTRUCT / OPERATION PERMIT / EXISTING SYSTEM

PIN # 4756530507

APPLICANT: Ronald Skinner APPLICANT ADDRESS: 329 Nixon Rd.

SITE ADDRESS: 181 W. Meadowview Dr. PHONE: 704-929-9805 ALT. PHONE: N/A

SITE DIRECTIONS: Hwy 21 N TR Jane Sowers TR E. Meadowview TR W. Meadowview

SUBDIVISION: Meadowview Estates SECTION: 2 LOT # 67 LOT AREA: 0.42 acres DESIGN FLOW: 360gpd L.T.A.R.: 0.25

Septic Tank 1000 (gal) STB 1012-1600 Date 4-18-15
Pump Tank (gal) PT Date
Pump Make Model Serial #
Nitrification Fields 1 # Lines 7 Linear Ft: 360
Trench Width 36" Max. Trench Bottom Depth 36" Gravel Depth N/A


☑ New System ☐ Repair ☐ Expansion System Type: I II (III) IV V VI
System Description: 25% Reduction
Repair System Description: 50% Reduction
Maintenance Agreement Required: ☐ YES ☑ NO
☐ GRAVITY ☐ PRESSURE

☑ Residence ☐ Business ☐ Other ☐ Slab ☐ Basement w/plumbing
No. Bedrooms 3 No. Persons 6 No. Employees ☑ Crawl Space

Water Supply: ☐ Private ☑ Public ☐ Community
☐ Basement w/o plumbing

Comments / Conditions: Install a 25% Reduction system on contour with serial distribution.

INITIAL SITE SKETCH

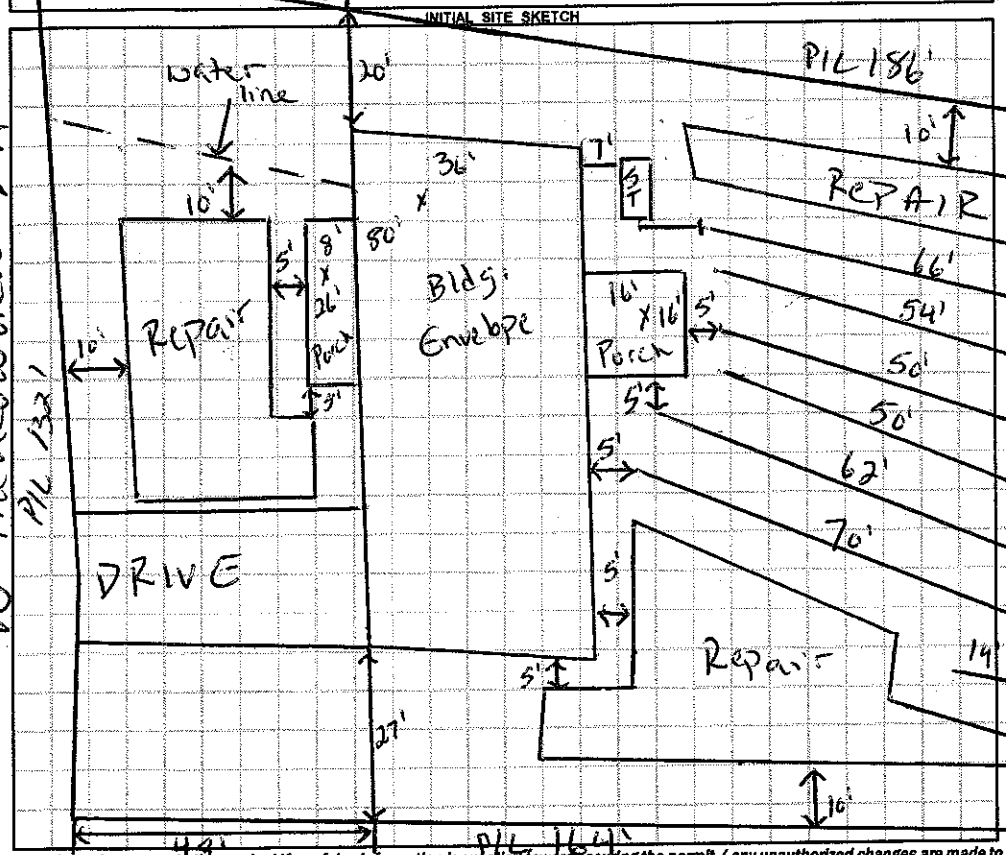

AS BUILT SKETCH

1" = 30'

- Quick 4 Chambers installed
- Yellow Tuf-Tite filter installed
- Installed as drawn

Permit can be suspended or revoked if any false information is supplied toward securing the permit / any unauthorized changes are made to the site / any unauthorized changes are made in the installation of the system. CONTACT A LOCATOR SERVICE PRIOR TO ANY EXCAVATION

☐ IMPROVEMENT PERMIT *with plat* valid without expiration. ☐ IMPROVEMENT PERMIT *with site plan* valid for 60 mos. ☑ AUTHORIZATION TO CONSTRUCT valid for period equal to IMPROVEMENT PERMIT--not to exceed 60 mo.

Owner / Applicant Signature: Date:

IMPROVEMENT PERMIT by: Justin Henderson Date: 12-16-15

AUTHORIZATION TO CONSTRUCT by: Justin Henderson Date: 12-16-15

Installed by: Tommy Frye

OPERATION PERMIT by: Justin Henderson Date: 12-16-15

Existing System Inspected by: Date:

Health Dept. Copy - WHITE Applicant (Final Approval) - YELLOW Applicant (Conditional Approval) - PINK