IREDELL COUNTY HEALTH DEPARTMENT

STATESVILLE 704-878-5305 MOORESVILLE 704-664-5281

IMPROVEMENT PERMIT / AUTHORIZATION TO CONSTRUCT / OPERATION PERMIT / EXISTING SYSTEM INSPECTION

PERMIT# 73974 PIN# 4756538222 DATE 6-16-98

OWNER OR CONTRACTOR Ronnie Fruia PHONE: Business _____ Home 838 1937

ADDRESS 111 Arizona Dr. Statesville N.C.

LOCATION Old Mocksville Rd TL Brookview TL Newmexico TL Arizona 2nd Left

SUBDIVISION _____ BLOCK / SECTION _____ LOT _____ LOT AREA 1/2 acre SITE CLASS. _____ DESIGN FLOW 360 L.T.A.R. _____

Septic Tank: 1500 Gallons; STB _____ Date _____

Pump Tank: _____ Gallons; PT _____ Date _____

Pump Make: _____ Model _____ Serial No. _____

Nitrification Field: No Fields _____ Square Feet _____ Linear Feet _____

No Lines _____ Trench Width _____ Max Trench Bottom Depth _____ Gravel Depth _____

☐ New System ☐ Repair System Type: I, II, III, IV, V, VI

System Description: _____

Repair System Description: _____

Maintenance Agreement Required: ☐ Yes ☐ No

☐ House/Mod. Home ☐ Mobile Home ☐ Business ☐ Other _____

No. Bedrooms 3 No. Bathrooms 2 No. Employees _____

☐ Slab ☐ Crawl Space ☐ Basement w/plumbing ☐ Basement wo/plumbing


Water Supply: ☐ Individual ☑ Public ☐ Community

Comments:/Conditions:

Comments:/Conditions:

INITIAL SITE SKETCH

AS BUILT SKETCH

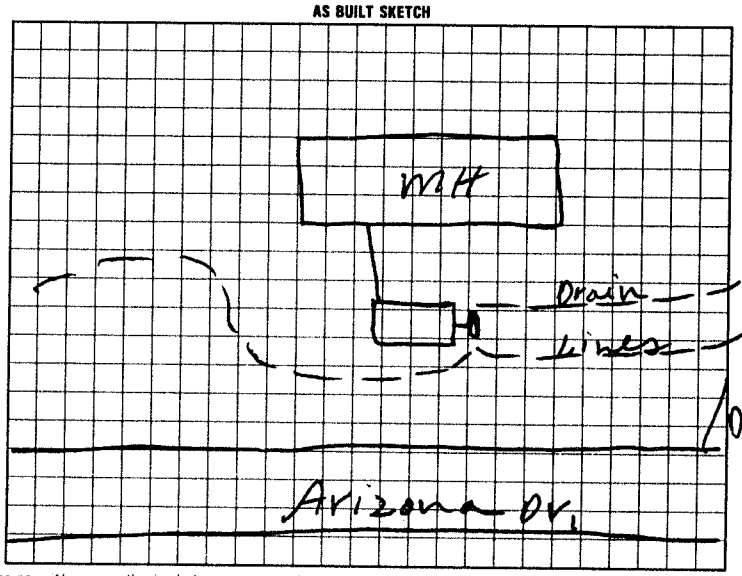

I understand that this permit can be suspended or revoked if any false information is supplied toward securing the permit/any unauthorized changes are made to the site/any unauthorized changes are made in the installation of the system. Improvement Permit with plat valid without expiration. Improvement Permit with site plan valid for sixty months. Authorization to Construct is valid for a period equal to that of Improvement Permit – not to exceed sixty months.

Signed: _____ date _____ Installed by: _____

Improvement Permit by: _____ date _____ Operation Permit by: _____ date _____

Authorization to Construct by: _____ date _____ Existing System Inspection by: R. C. Moore date 6-16-98

HEALTH DEPT. COPY: WHITE INSPECTION COPY (FINAL): GREEN OWNER COPY (FINAL) YELLOW INSPECTION COPY (INITIAL) PINK OWNER COPY (INITIAL): GOLD