BROOK VIEW MHP LOT 24A

IREDELL COUNTY HEALTH DEPARTMENT

STATESVILLE 704-878-5305 MOORESVILLE 704-664-5281

IMPROVEMENT PERMIT / AUTHORIZATION TO CONSTRUCT / OPERATION PERMIT / EXISTING SYSTEM INSPECTION

PERMIT# _____ PIN# _____ DATE 4-30-01

OWNER OR CONTRACTOR BROOKVIEW MHP NEW MEXICO DRIVE PHONE. Business MANAGER 450-7467 Home _____

ADDRESS LOT 24A-137 [redacted], STATESVILLE, NC 28625

LOCATION HWY 21A, ⓑ JANESOWCRS, ⓒ CRAWFORD, ⓓ BROOKVIEW, ON LEFT DOWN ARIZONA DRIVE

SUBDIVISION BROOKVIEW MHP BLOCK / SECTION _____ LOT 24A LOT AREA _____ SITE CLASS. _____ DESIGN FLOW _____ L.T.A.R. _____

Septic Tank: EXISTING Gallons: STB _____ Date _____

Pump Tank: _____ Gallons: PT _____ Date _____

Pump Make: _____ Model _____ Serial No. _____

Nitrification Field: No Fields 1 Square Feet _____ Linear Feet 190'

No Lines 2 Trench Width 36" Max Trench Bottom Depth _____ Gravel Depth (24") ☐ Slab ☒ Crawl Space ☐ Basement w/plumbing ☐ Basement wo/plumbing

☐ New System ☒ Repair System Type: I. (II.) III. IV. V. VI

System Description: CONV GRAV

Repair System Description: _____

Maintenance Agreement Required: ☐ Yes ☐ No

☐ House/Mod. Home ☒ Mobile Home ☐ Business ☐ Other


No. Bedrooms ____ No. Bathrooms ____ No. Employees ____

Water Supply: ☐ Individual ☒ Public ☐ Community

Comments/Conditions: ① INSTALL NEW SANITARY TEE IN TANK ② SYSTEM IS FLAGGED OUT ③ STAY 15' off the embankment ④ REROUTE H2O LINE TO MAINTAIN 10' SEPERATION BETWEEN THEM & SEPTIC SYSTEM IF POSSIBLE.

Comments/Conditions: ⑤ IF HAVE ANY QUESTIONS, I WILL MEET YOU OUT THERE PRIOR TO CONSTRUCTION. 704-928-2030 CORNE LOCK PST

INITIAL SITE SKETCH

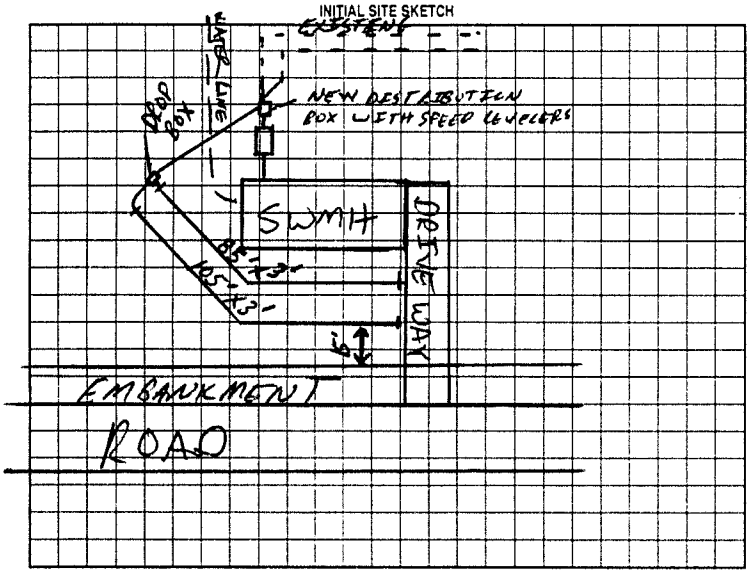

AS BUILT SKETCH

SYSTEM REPAIRED ACCORDING TO INITIAL SITE SKETCH

Permit can be suspended or revoked if any false information is supplied toward securing the permit/any unauthorized changes are made to the site/any unauthorized changes are made in the installation of the system. Improvement Permit with plat valid without expiration. Improvement Permit with site plan valid for sixty months. Authorization to Construct is valid for a period equal to that of Improvement Permit – not to exceed sixty months.

Signed: Tracy D. Pope date 5/9/01

Improvement Permit by: Jim Cook REI date 4-30-01

Authorization to Construct by: Jim Cook REI date 4-30-01

Installed by: STEVE JORDAN

Operation Permit by: STEVE HERRICK date 7-5-01

Existing System Inspection by: _____ date _____

HEALTH DEPT. COPY WHITE OWNER COPY (FINAL) YELLOW OWNER COPY (INITIAL) PINK