IREDELL COUNTY HEALTH DEPARTMENT

Statesville Phone TR 3-7271 — Mooresville Phone NO 3-1271

PERMIT TO INSTALL SEPTIC TANK

Permit NO. 34 — Permit Date 8-2 1972

Owner FRANK GOFORTH M & E SALES — Address STATESVILLE, N.C.

Installed By HARLEE LACKEY — Address STONY POINT, N.C.


Location of Property BROOKVIEW TRAILER PARK OFF OLD MOORESVILLE Rd. LOT 24-A

Tank		Capacity		Length of Lines		Fixtures	
Block	( )	1000	(✓)	225'	(✓)	No. of Baths	(1)
Precast	(✓)	1250	( )	250'	( )	Dishwasher	( )
		1500	( )	Other		Garbage Grdr.	( )
		Other				Other	

NOTIFY HEALTH DEPARTMENT AT LEAST EIGHT HOURS BEFORE TANK IS TO BE INSPECTED.

Final Inspection 8-2 1972 — Approved (✓) Disapproved ( )

Remarks COMMUNITY WATER SUPPLY

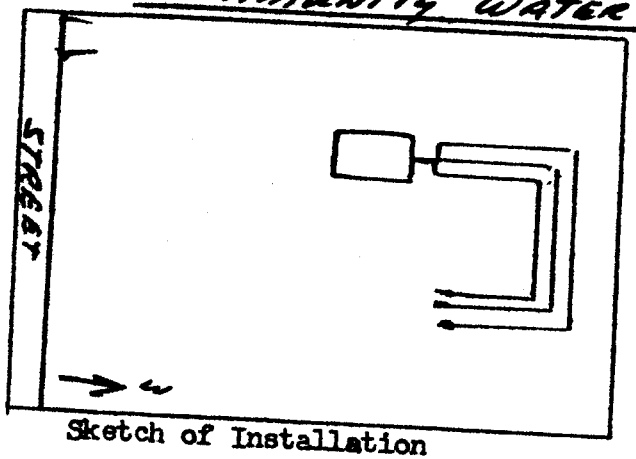

Sketch of Installation

Nitrification Lines 3 to 5 Feet Deep -

Crown property line on Back

Sanitarian