BROOKVIEW MHP LOT 26A

IREDELL COUNTY HEALTH DEPARTMENT

STATESVILLE 704-878-5305 MOORESVILLE 704-664-5281

IMPROVEMENT PERMIT / AUTHORIZATION TO CONSTRUCT / OPERATION PERMIT / EXISTING SYSTEM INSPECTION

PERMIT# _____ PIN# _____

OWNER OR CONTRACTOR BROOKVIEW MOBILE HOME PARK PHONE: Business MANAGER 450-7467 Home _____ DATE 4-30-01

ADDRESS LOT 26A - 105 [redacted] 105 NEW MEXICO AV, STATESVILLE, NC 28625

LOCATION HWY 21 NORTH, R JANE SOWERS R CRAWFORD L BROOKVIEW R ARIZONA, ON LEFT PAST CREEK

SUBDIVISION BROOKVIEW MHP BLOCK / SECTION _____ LOT 26A LOT AREA _____ SITE CLASS _____ DESIGN FLOW _____ L.T.A.R. _____

Septic Tank: EXISTING Gallons: STB _____ Date _____
Pump Tank: _____ Gallons: PT _____ Date _____
Pump Make: _____ Model _____ Serial No. _____
Nitrification Field: No Fields 1 Square Feet _____ Linear Feet 230'
No Lines 4 Trench Width 36" Max Trench Bottom Depth _____

☐ New System ☒ Repair System Type: I, (II), III, IV, V, VI
System Description: CONV GRAV
Repair System Description: _____
Maintenance Agreement Required: ☐ Yes ☐ No
Gravel Depth (18") ☐ Slab ☒ Crawl Space ☐ Basement w/plumbing ☐ Basement wo/plumbing


☐ House/Mod. Home No. Bedrooms ____
☒ Mobile Home No. Bathrooms ____
☐ Business No. Employees ____
☐ Other _____

Water Supply: ☐ Individual ☒ Public ☐ Community

Comments/Conditions: ① INSTALL NEW SANITARY TEE IN TANK ② SYSTEM IS FLAGGED OUT ③ STAY 15' off EMBANKMENT ④ REROUTE H2O LINES TO MAINTAIN 10' SEPERATION BETWEEN THEM & SEPTIC SYSTEM IF POSSIBLE

Comments/Conditions: ⑤ IF HAVE ANY QUESTIONS, I WILL MEET YOU OUT THERE PRIOR TO CONSTRUCTION 704 928-2030, LORNE COOK RSI

INITIAL SITE SKETCH

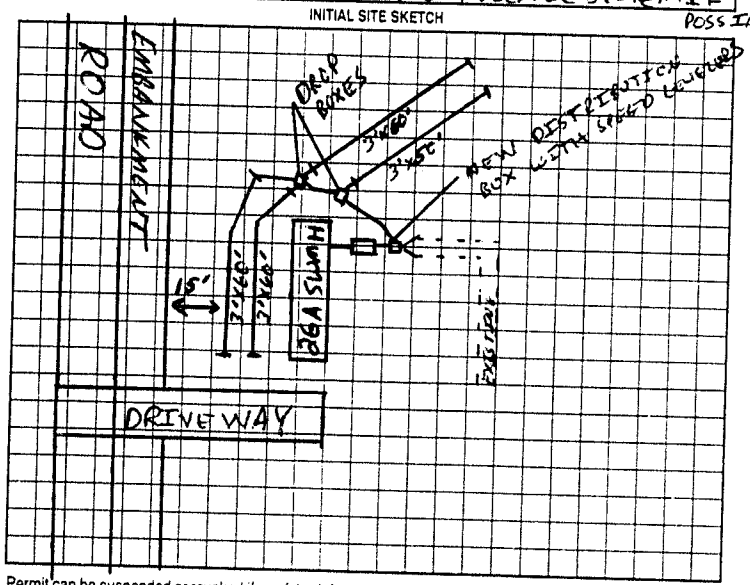

AS BUILT SKETCH

SYSTEM REPAIRED ACCORDING TO INITIAL SITE SKETCH

Permit can be suspended or revoked if any false information is supplied toward securing the permit/any unauthorized changes are made to the site/any unauthorized changes are made in the installation of the system. Improvement Permit with plat valid without expiration. Improvement Permit with site plan valid for sixty months. Authorization to Construct is valid for a period equal to that of Improvement Permit – not to exceed sixty months.

Signed: Tracy D. Payne date 5/9/01

Improvement Permit by: Lorne Cook RSI date 4-30-01

Authorization to Construct by: Lorne Cook RSI date 4-30-01

Installed by: STEVE JORDAN

Operation Permit by: STEVE HEDRICK date 7-6-01

Existing System Inspection by: _____ date _____

HEALTH DEPT COPY WHITE OWNER COPY (FINAL) YELLOW OWNER COPY (INITIAL) PINK