IREDELL COUNTY HEALTH DEPARTMENT

STATESVILLE 704-878-5305 MOORESVILLE 704-664-5281

IMPROVEMENT PERMIT / AUTHORIZATION TO CONSTRUCT / OPERATION PERMIT / EXISTING SYSTEM INSPECTION

PERMIT # 134799 PIN # 4756 53 9800 7440 and 7443 DATE 3-12-09

OWNER or APPLICANT Leonardo Valle PHONE: Business Home: 704-8005126

OWNER or APPLICANT ADDRESS 140 Augusta Drive Statesville 28625

LOCATION / DIRECTIONS Old Mocksville Rd

SUBDIVISION Brookwood MHP BLOCK / SECTION LOT # 33 LOT AREA DESIGN FLOW 360 L.T.A.R. EVAL

Septic Tank 1000 EVAL Gallons: STB Date

Pump Tank Gallons: P T Date

Pump Make Model Serial #

Nitrification Field No Fields No Lines Linear Feet 300

Trench Width 36" Max. Trench Bottom Depth 36" Gravel Depth 12

☑ New System EVAL ☐ Repair ☐ Expansion System Type I II III IV V VI

System Description: Existing

Repair System Description: 2590 Repair

Maintenance Agreement Required ☐ YES ☑ NO

☑ GRAVITY ☐ PRESSURE

☑ Residence No. Bedrooms 3

☐ Business No. Persons

☐ Other No. Employees

☐ Slab ☐ Crawl Space


☐ Basement w/plumbing ☐ Basement w/o plumbing

Water Supply: ☐ Private ☑ Public ☐ Community


Comments / Conditions

Comments / Conditions

INITIAL SITE SKETCH

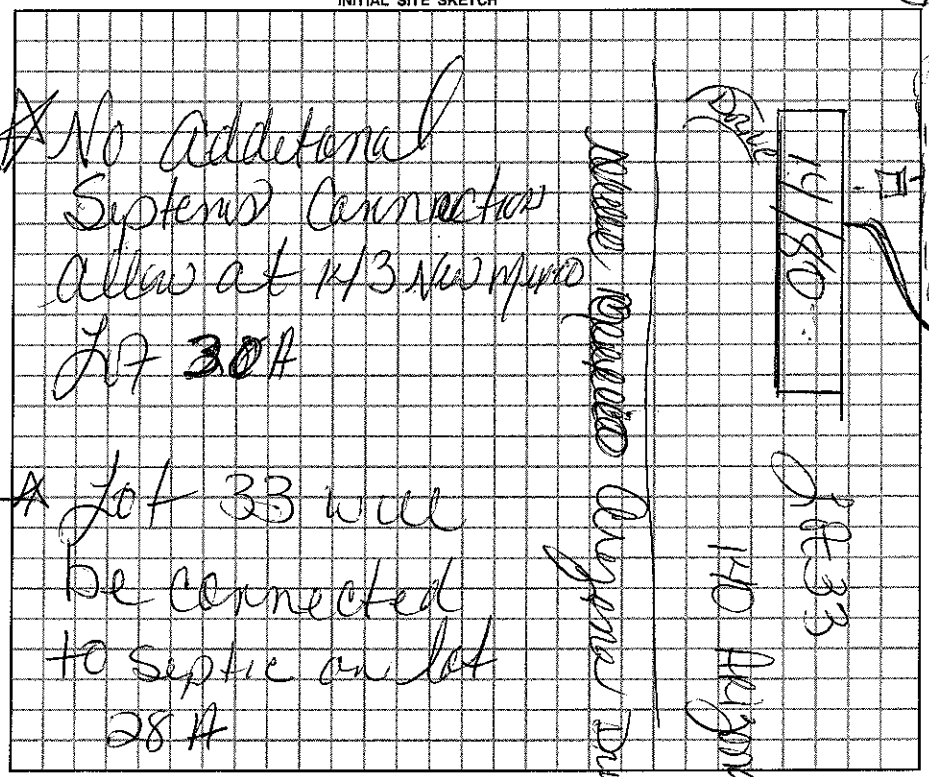

AS BUILT SKETCH

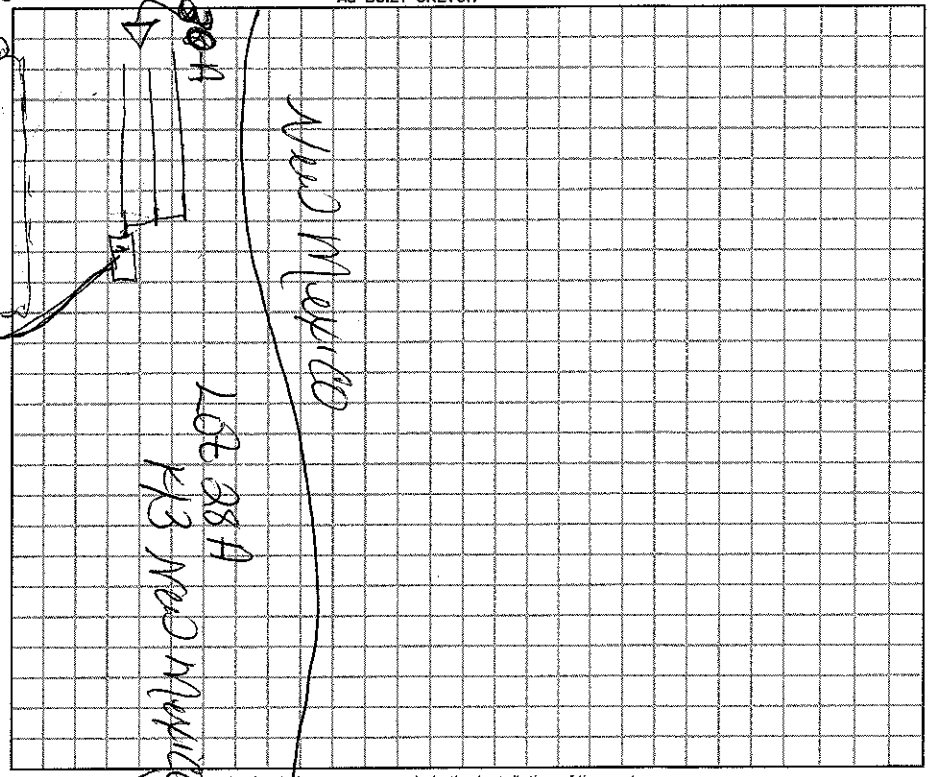

Permit can be suspended or revoked if any false information is supplied toward securing the permit / any unauthorized changes are made to the site / any unauthorized changes are made in the installation of the system.

☐ *IMPROVEMENT PERMIT w / plat valid without expiration.* ☐ *IMPROVEMENT PERMIT w / site plan valid for 60 mos.* ☑ *AUTHORIZATION TO CONSTRUCT valid for period equal to IMPROVEMENT PERMIT-not to exceed 60 mo.*

Owner / Applicant Signature: Leonardo Valle Date 3/13/09

Improvement Permit by: Date

Authorization to Construct by: Date

YOU SHOULD CONTACT A LOCATOR SERVICE PRIOR TO ANY EXCAVATION.

Installed by:

Operation Permit by: Date:

Existing System Inspected by: Date: 3-13-09

WHITE COPY Environmental Health YELLOW COPY (Final) Owner / Applicant PINK COPY (Initial) Owner / Applicant