IREDELL COUNTY HEALTH DEPARTMENT

Statesville Phone TR 3-7271 Mooresville Phone NO 3-1271

PERMIT TO INSTALL SEPTIC TANK

Permit NO. 34 Permit Date 8-2 1972

Owner M & F SALES FRANK COFORTH Address STATESVILLE, NC

Installed By HARLEE LACKEY Address Stony Point, NC

Location of Property BROOKVIEW TRAILER PARK

OFF OLD MOCKSVILLE ROAD -


LOT - 26-A

Tank		Capacity		Length of Lines		Fixtures	
Block	( )	1000	(✓)	225'	(✓)	No. of Baths	(1)
Precast	(✓)	1250	( )	250'	( )	Dishwasher	( )
		1500	( )	Other		Garbage Grdr.	( )
		Other				Other	

NOTIFY HEALTH DEPARTMENT AT LEAST EIGHT HOURS BEFORE TANK IS TO BE INSPECTED.

Final Inspection 8-2 1972 Approved (✓) Disapproved ( )

Remarks COMMUNITY WATER SUPPLY

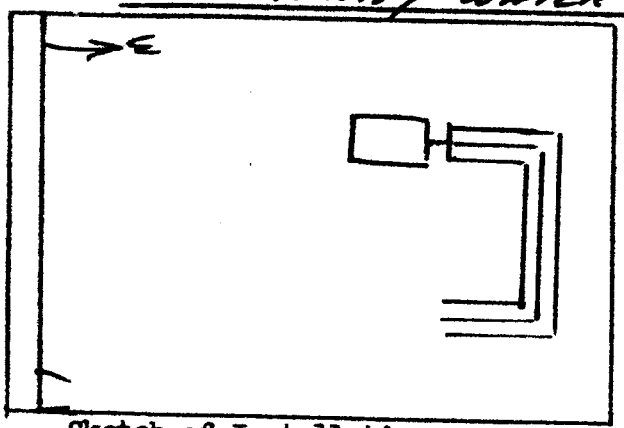

Sketch of Installation

Nitrification Line 3 to 5 feet deep.

Crown Property Line on Back

Glenn Fox Jr.

Sanitarian