IREDELL COUNTY HEALTH DEPARTMENT

Statesville Phone TR 3-7271 Mooresville Phone No. 664-5281

PERMIT TO INSTALL SEPTIC TANK

Permit No. 60 Permit Date 11-7 1972

Owner M & J. Sales Co. Address Statesville, N.C.

Installed By HARLEE LACKEY Address Stony Point, NC

Location of Property OLD MOCKSVILLE Rd.

BROOKVIEW TRAILER PARK


LAST TRAILER ON LEFT. 1ST STREET

Tank		Capacity		Length of Lines		Fixtures	
Block	( )	1000	(✓)	225'	(✓)	No. of Baths	(1)
Precast	(✓)	1250	( )	250'	( )	Dishwasher	( )
		1500	( )	Other		Garbage Grdr.	( )
		Other				Other	

NOTIFY HEALTH DEPARTMENT AT LEAST EIGHT HOURS BEFORE TANK IS TO BE INSPECTED.

Final Inspection 11-7 1972 Approved (✓) Disapprcved ( )

Remarks Community Water Supply

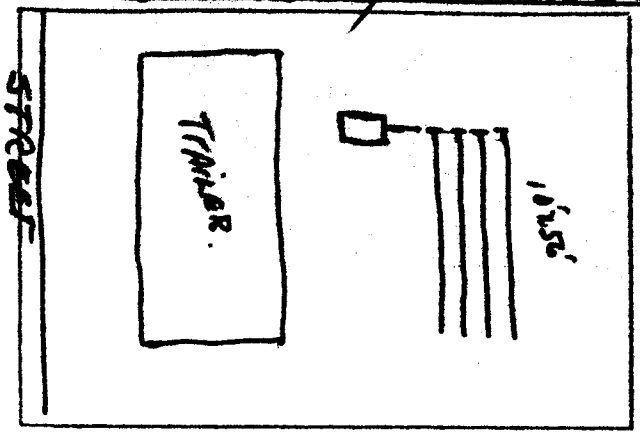

Sketch of Installation

Sanitarian