IREDELL COUNTY HEALTH DEPARTMENT

Statesville Phone TR 3-7271 Mooresville Phone No. 664-5281

PERMIT TO INSTALL SEPTIC TANK

Permit No. _____ Permit Date 5 Apr 1973

~~Owner~~ Builder Icehouse Building Co. Address Statesville

Installed By Icehouse Building Co Address Statesville

Location of Property Meadow View Estates


Lot #14

Tank		Capacity		Length of Lines		Fixtures	
Block	( )	1000	( )	225'	( )	No. of Baths	(2)
Precast	(✓)	1250	(✓)	250'	( )	Dishwasher	(✓)
		1500	( )	Other 255'		Garbage Grdr.	(✓)
		Other _____				Other _____	

NOTIFY HEALTH DEPARTMENT AT LEAST EIGHT HOURS BEFORE TANK IS TO BE INSPECTED.

Final Inspection 5 Apr 1973 Approved (✓) Disapproved ( )

Remarks Iredell Water

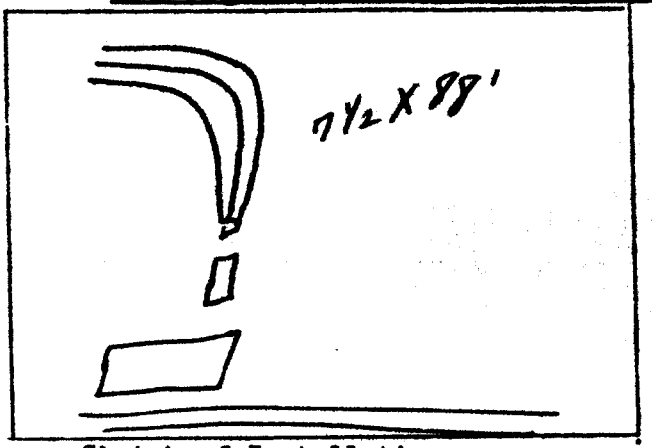

Sketch of Installation

W. M. Howard & Son Jr.

Sanitarian