IREDELL COUNTY HEALTH DEPARTMENT

Statesville Phone TR 3-7271 Mocresville Phone No. 664-5281

PERMIT TO INSTALL SEPTIC TANK

Permit No. _____ Permit Date 7-13 1923

Owner Bldr. ALFRED LEVAN Address STATESVILLE, NC

Installed By HERMAN GIBSON Address STATESVILLE, NC


Location of Property MEADOWVIEW ESTATES - LOT. #13

Tank		Capacity		Length of Lines		Fixtures	
Block	( )	1000	(✓)	225'	( )	No. of Baths	(1½)
Precast	(✓)	1250	( )	250'	( )	Dishwasher	(✓)
		1500	( )	Other 240		Garbage Grdr.	( )
		Other _____				Other _____	

NOTIFY HEALTH DEPARTMENT AT LEAST EIGHT HOURS BEFORE TANK IS TO BE INSPECTED.

Final Inspection 7-13 1923 Approved (✓) Disapproved ( )

Remarks IREDELL WATER Corp.

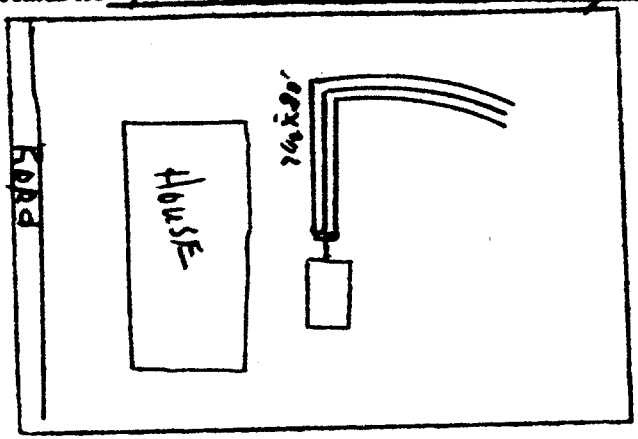

Sketch of Installation

Glenn Todd Jr.

Sanitarian