IREDELL COUNTY HEALTH DEPARTMENT

4 stcv 2:30

STATESVILLE 704-878-5305 MOORESVILLE 704-664-5281

IMPROVEMENT PERMIT / CERTIFICATE OF COMPLETION / OPERATION PERMIT / EXISTING SYSTEM INSPECTION

PROPERTY DESCRIPTION NO. _____ DATE 10-9-95 TAX MAP NO. _____ Watershed: ☐ Yes ☐ No

OWNER OR CONTRACTOR Patrick + lisa Hardig PHONE: Business _____ Home 876-2194

ADDRESS 167 Dellinger Dr.

LOCATION 21N TR Jane Sowers TR Donna Ln TL Dellinger 4th Hse left

SUBDIVISION meadowview BLOCK / SECTION _____ LOT 41 LOT AREA 1.50005ac+ SITE CLASS. PS DESIGN FLOW 360 L.T.A.R. .3

Septic Tank: EX 1000 Gallons; STB _____ Date _____

Pump Tank: 1000 Gallons; PT 17 Date 2-7-95

Pump Make: Goulds Model WE0M12H Serial No. 22888325

Nitrification Field: No Fields 1 Square Feet 1050 Linear Feet 360

No Lines 6 Trench Width 36" Max Trench Bottom Depth 36" Gravel Depth 12"

☐ New System ☐ Repair System Type: I, II, III, IV, V, VI

System Description: _____

Repair System Description: 1st option Pump to conv. Lines 6' Bed System

Maintenance Agreement Required: ☐ Yes ☐ No

☑ House/Mod. Home No. Bedrooms 3

☐ Mobile Home No. Bathrooms 2

☐ Business No. Employees _____

☐ Other _____


☐ Slab ☐ Crawl Space ☐ Basement w/plumbing ☐ Basement wo/plumbing

Water Supply: ☐ Individual ☐ Community ☑ Public


Comments: See Two attached Sheets for P.T. + manifold set up.

Comments: P. Tank + Drain lines + Pump Cycled 10-31-95 fcm

INITIAL SITE SKETCH

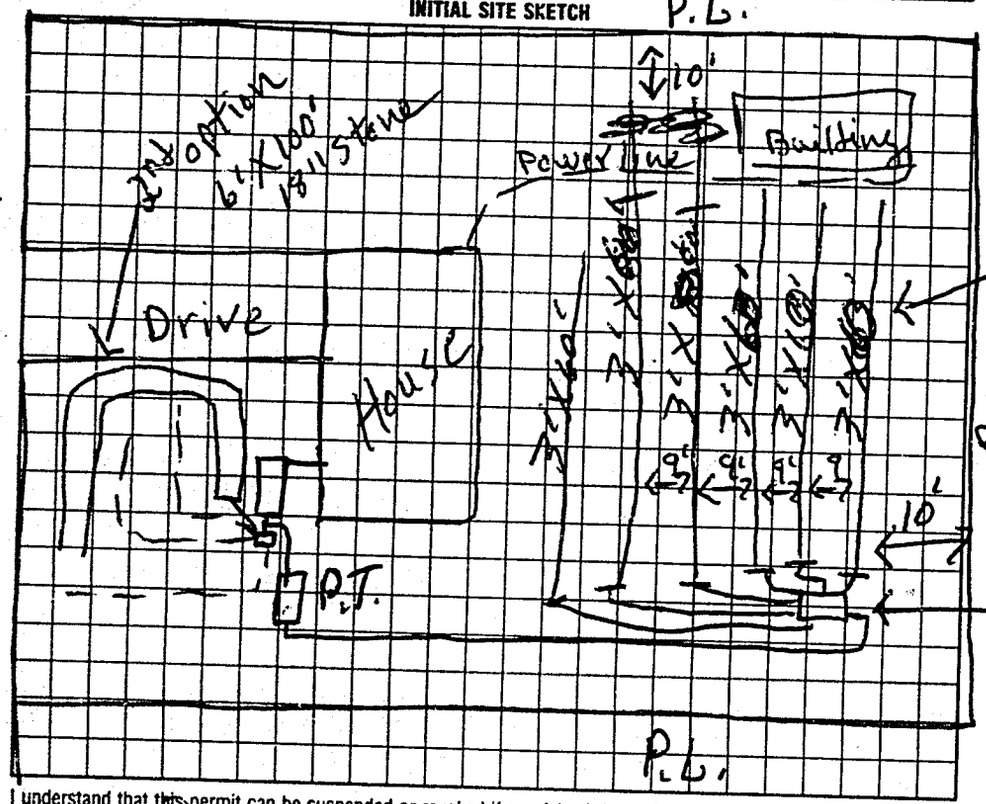

AS BUILT SKETCH

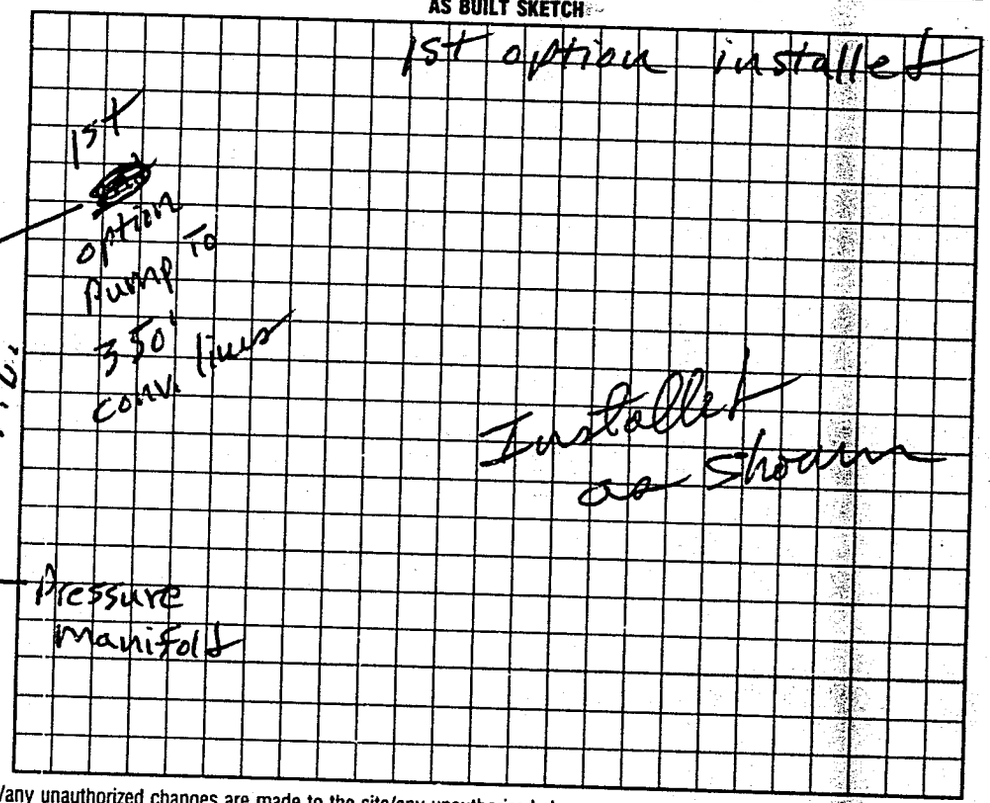

I understand that this permit can be suspended or revoked if any false information is supplied toward securing the permit/any unauthorized changes are made to the site/any unauthorized changes are made in the installation of the system.

Signed: Lisa D. Hardig

Improvement Permit by: f.c. moore date 10-9-95

Authorization to Existing System Inspection by: f.c. moore date 10-9-95

Const. HEALTH DEPT. COPY: WHITE INSPECTION COPY (FINAL): GREEN OWNER COPY (FINAL): YELLOW

Installed by: Donald Tucker

Certificate of Completion by: _____ date _____

Operation Permit by: f.c. moore date 5-18-95

INSPECTION COPY (INITIAL) PINK OWNER COPY (INITIAL) GOLD

Authorization to const. Expires 60 mos from date of issue.