IREDELL COUNTY HEALTH DEPARTMENT

Statesville Phone TR 3-7271 Mooresville Phone No. 664-5281

PERMIT TO INSTALL SEPTIC TANK

Permit No. 41 Permit Date 5-24 1973

Owner Gilbert Lackey Bldr Address Statesville N.C.

Installed By Lackey Bro Address Stony Point N.C.


Location of Property Meadow View - Division # 2
Lot # 14 - Straight on Past Cabinet Shop
House on R.

Tank		Capacity		Length of Lines		Fixtures	
Block	( )	1000	( )	225'	( )	No. of Baths	(2)
Precast	(✓)	1250	(✓)	250'	( )	Dishwasher	(✓)
		1500	( )	Other 255'		Garbage Grdr.	(✓)
		Other				Other	

NOTIFY HEALTH DEPARTMENT AT LEAST EIGHT HOURS BEFORE TANK IS TO BE INSPECTED.

Final Inspection 5-24 1973 Approved (✓) Disapproved ( )

Remarks Iredell Water Corp

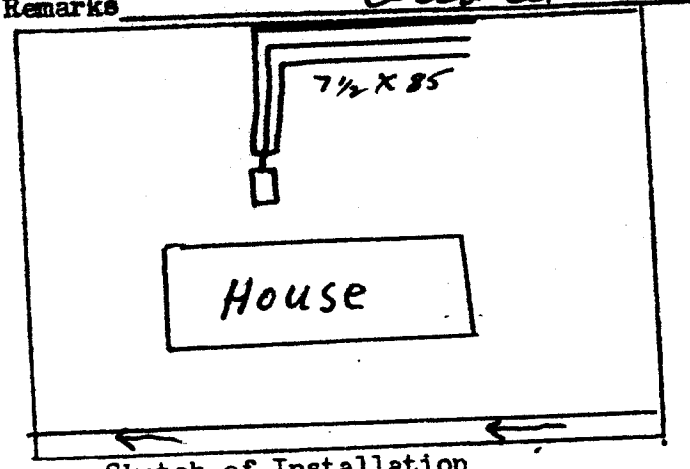

Sketch of Installation

E. A. Stevenson
Sanitarian