IREDELL COUNTY HEALTH DEPARTMENT - *ENVIRONMENTAL HEALTH* ☐ STATESVILLE OFFICE 704-878-5305 ☐ MOORESVILLE OFFICE 704-664-5281

IMPROVEMENT PERMIT / AUTHORIZATION TO CONSTRUCT / OPERATION PERMIT / EXISTING SYSTEM INSPECTION

PERMIT # 167309 PIN # 4756-56-1671 DATE 13 July 2011

OWNER Chad/LACKEY APPLICANT: WAC Construct PHONE: Home/Cell # (704) 361-1085 Business #

SITE ADDRESS 642 Jane Sowers Rd. OWNER / APPLICANT ADDRESS

SITE DIRECTIONS Hwy 21N TR Jane Sowers Rd. Site on Rt.

SUBDIVISION Meadowview Est. BLOCK / SECTION LOT # 15 LOT AREA 18,000 ft² DESIGN FLOW 360 gpd L.T.A.R. 0.3 gpd/ft²

Septic Tank Exist. Gallons: STB Date

Pump Tank Gallons: P T Date

Pump Make Model Serial #

No. Nitrification Fields: No. Lines 3 Linear Feet 400

Trench Width NA Max. Trench Bottom Depth NA Gravel Depth 12"

☐ New System ☐ Repair ☐ Expansion System Type I II IV V VI

System Description: gravity conventional

Repair System Description:

Maintenance Agreement Required ☐ YES ☒ NO

☒ GRAVITY ☐ PRESSURE

☐ Residence ☐ Business ☐ Other ☐ Slab ☐ Basement w/plumbing

No. Bedrooms 3 No. Persons No. Employees ☒ Crawl Space ☐ Basement w/o plumbing


Water Supply: ☒ Private ☐ Public ☐ Community

Comments / Conditions

18'x20' Bedroom addition does not impact the existing septic system

INITIAL SITE SKETCH

AS-BUILT SKETCH

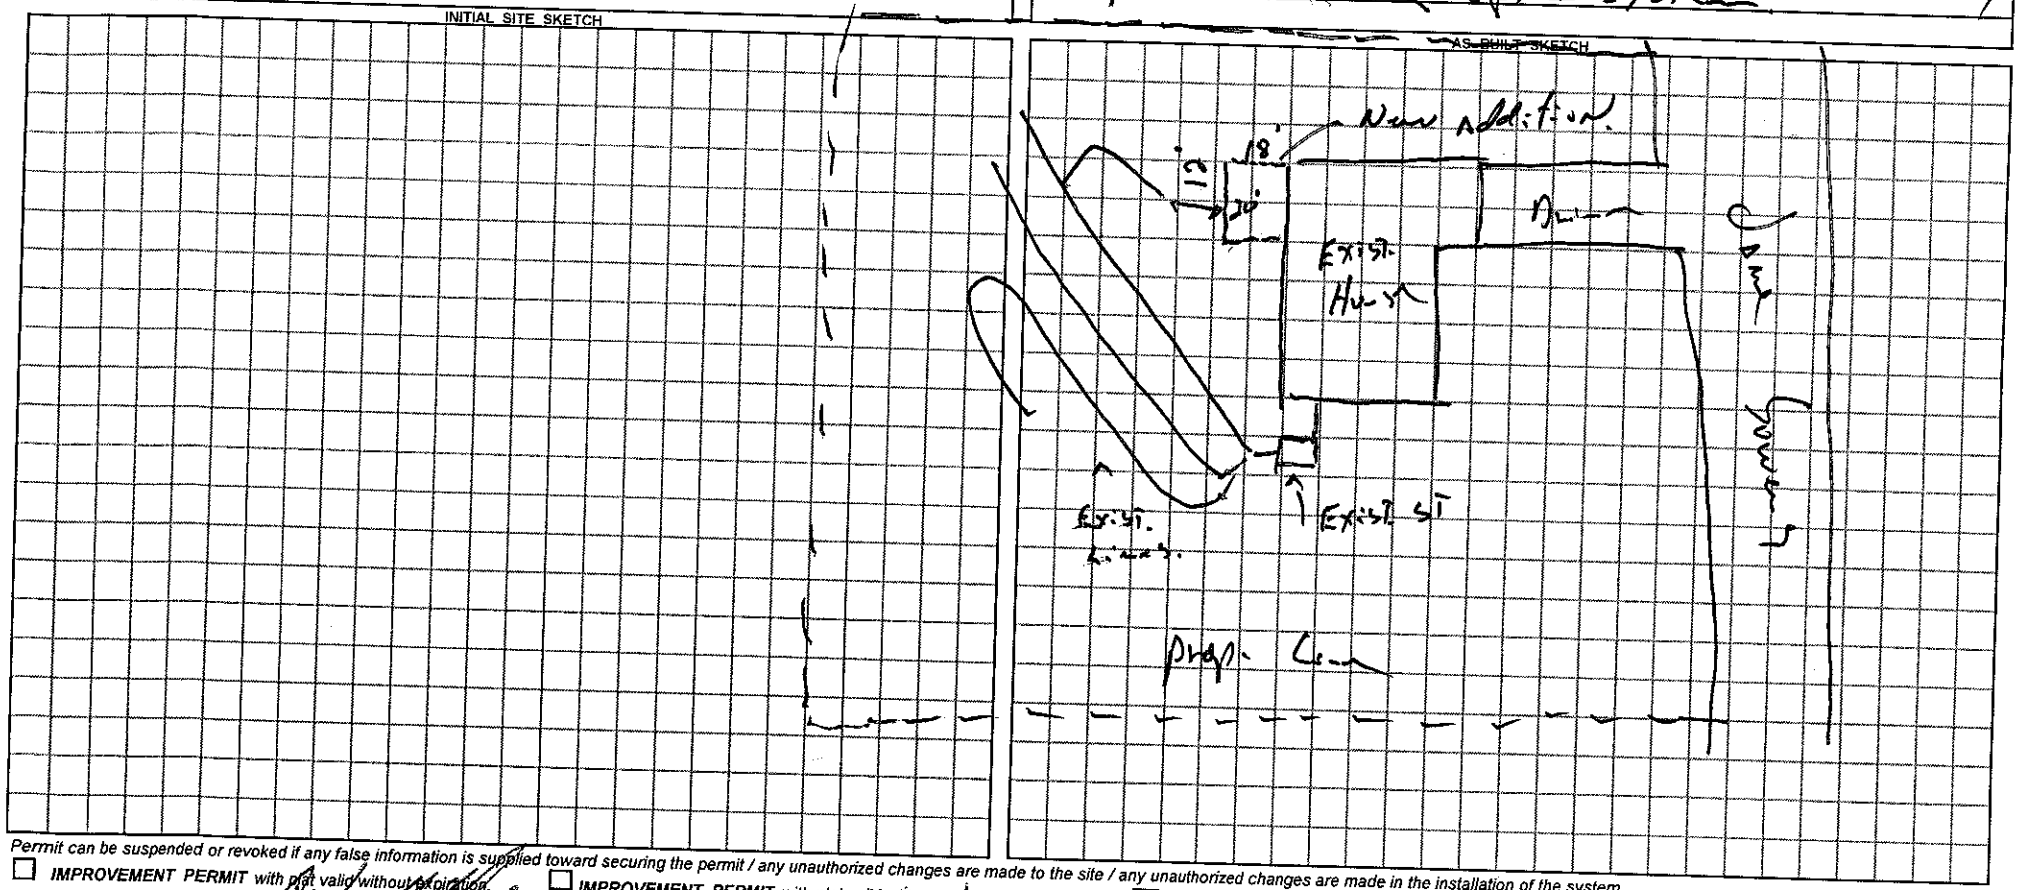

Permit can be suspended or revoked if any false information is supplied toward securing the permit / any unauthorized changes are made to the site / any unauthorized changes are made in the installation of the system.

☐ ***IMPROVEMENT PERMIT*** with plat valid without expiration.

☐ ***IMPROVEMENT PERMIT*** with plat valid w/appropriation. site plan valid 60 mo.

☐ ***AUTHORIZATION TO CONSTRUCT*** valid for period equal to IMPROVEMENT PERMIT--not to exceed 60 mo.

Owner / Applicant Signature: Date 7/29/2011 Installed by:

IMPROVEMENT PERMIT by: REHS Date

AUTHORIZATION TO CONSTRUCT by: REHS Date

OPERATION PERMIT by: REHS Date

Existing System Inspected by: REHS Date 13 July 11

YOU SHOULD CONTACT A LOCATOR SERVICE PRIOR TO ANY EXCAVATION

White Copy – Environmental Health YELLOW COPY (Final) Owner / Applicant PINK COPY (Initial) Owner / Applicant