IREDELL COUNTY HEALTH DEPARTMENT

Statesville Office (704) 878-5305 Mooresville Office (704) 660-3625 PERMIT # 217188

IMPROVEMENT PERMIT / AUTHORIZATION TO CONSTRUCT / OPERATION PERMIT / EXISTING SYSTEM

PIN # 4756563013 ✓

APPLICANT: Kevin Osborne APPLICANT ADDRESS: 166 Dellinger Dr Statesville NC

SITE ADDRESS: 166 Dellinger Dr Statesville NC PHONE: 704-876-0152 ALT. PHONE: N/A

SITE DIRECTIONS: 21N T/R Jane Sowers T/R Donna Ln T/L Dellinger Lot on right


SUBDIVISION: Meadowview SECTION: 52m1 LOT # 59 LOT AREA: 0.96ac DESIGN FLOW: 360 L.T.A.R.: Ex

Septic Tank	Ex (gal)	STB	Date	☐ New System	☒ Repair	☐ Expansion	System Type: I II III IV V VI	☒ Residence	No. Bedrooms 3
Pump Tank	(gal)	PT	Date	System Description: D-Box				☐ Business	No. Persons 6
Pump Make	Model		Serial #	Repair System Description:				☐ Other	No. Employees
# Nitrification Fields	Ex # Lines Ex		Linear Ft: Ex	Maintenance Agreement Required:	☐ YES	☒ NO		☒ Slab	☐ Crawl Space
Trench Width	Ex Max. Trench Bottom Depth Ex		Gravel Depth Ex		☒ GRAVITY	☐ PRESSURE		☐ Basement w/plumbing	☐ Basement w/o plumbing

Water Supply: ☐ Private ☒ Public ☐ Community

Comments / Conditions: Replace distribution box and adjust to fill last of upper lines before stepping down.

INITIAL SITE SKETCH

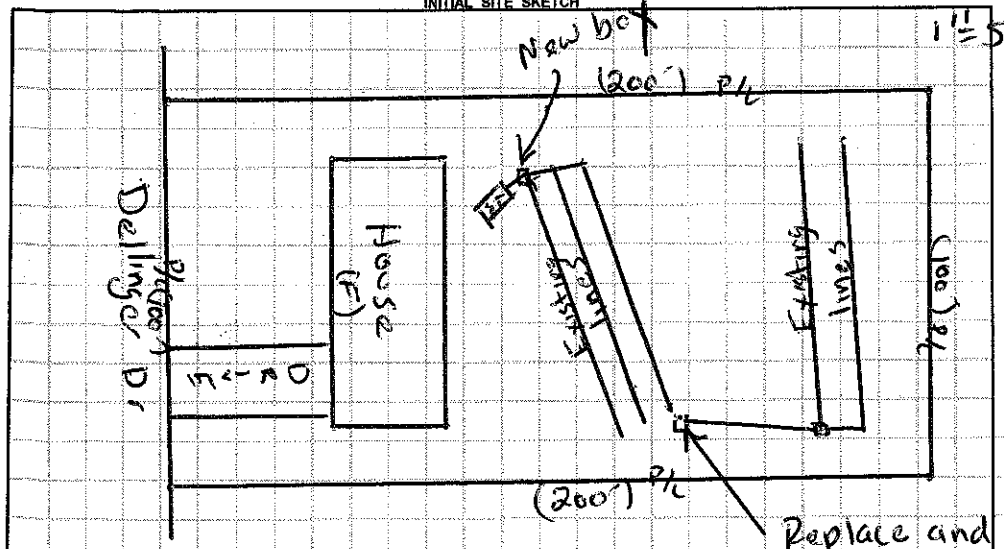

AS BUILT SKETCH

1" = 50'

Installed as drawn

Permit can be suspended or revoked if any false information is supplied toward securing the permit / any unauthorized changes are made to the site / any unauthorized changes are made in the installation of the system. **CONTACT A LOCATOR SERVICE PRIOR TO ANY EXCAVATION**

☐ **IMPROVEMENT PERMIT** *with plat valid without expiration.* ☒ **IMPROVEMENT PERMIT** *with site plan valid for 60 mos.* ☒ **AUTHORIZATION TO CONSTRUCT** *valid for period equal to IMPROVEMENT PERMIT--not to exceed 60 mo.*

Owner / Applicant Signature: Date: 03/15/16 Installed by: Steve Jordon

IMPROVEMENT PERMIT by: Date: 03/15/16 OPERATION PERMIT by: Date: 03/28/16

AUTHORIZATION TO CONSTRUCT by: Date: 03/15/16 Existing System Inspected by: Date:

Health Dept. Copy - WHITE Applicant (Final Approval) - YELLOW Applicant (Conditional Approval) - PINK