IREDELL COUNTY HEALTH DEPARTMENT

STATESVILLE 704-878-5305 MOORESVILLE 704-664-5281

IMPROVEMENT PERMIT / AUTHORIZATION TO CONSTRUCT / OPERATION PERMIT / EXISTING SYSTEM INSPECTION

PERMIT# 97849 PIN# 4756 57 1400 DATE 2-17-00

OWNER OR CONTRACTOR Tom Gregory PHONE: Business Home

ADDRESS 601 Red Fox Trail Statesville, N.C.

LOCATION Off Mocksville Tl to Jane Sowers TR 2nd Baymount Bear left Tl on Big oak Lane

SUBDIVISION Baymount meadows BLOCK / SECTION LOT 6 LOT AREA 2 acres SITE CLASS PS DESIGN FLOW 480 L.T.A.R. .03

Septic Tank: 1000 Gallons; STB 1012 Date 10-15-2000
Pump Tank: Gallons; PT Date
Pump Make: Model Serial No.
Nitrification Field: No Fields 1 Square Feet 1600 Linear Feet 533
No Lines 4 Trench Width 36" Max Trench Bottom Depth 36" Gravel Depth 12"

☒ New System ☐ Repair System Type: I ☒ II III IV V VI
System Description: Conv. Gravity
Repair System Description: 1L 1L
Maintenance Agreement Required: ☐ Yes ☒ No

☒ House/Mod. Home No. Bedrooms 4
☐ Mobile Home No. Bathrooms 2½
☐ Business No. Employees
☐ Other


☐ Slab ☒ Crawl Space ☐ Basement w/plumbing ☐ Basement wo/plumbing

Water Supply: ☐ Individual ☒ Public ☐ Community


Comments/Conditions:

Comments/Conditions: INSTALLED WITH POLYLOK FILTER + RISERS EXPOSED.

INITIAL SITE SKETCH

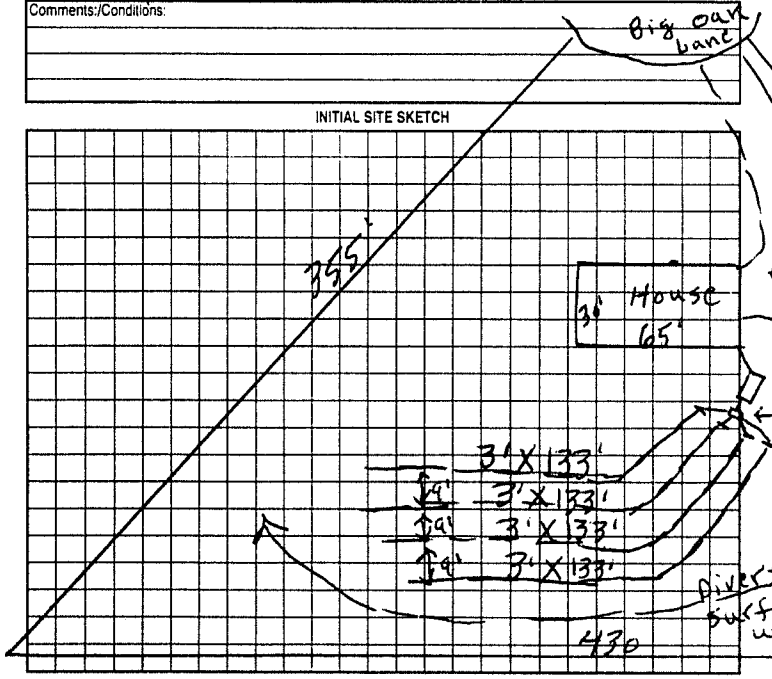

AS BUILT SKETCH

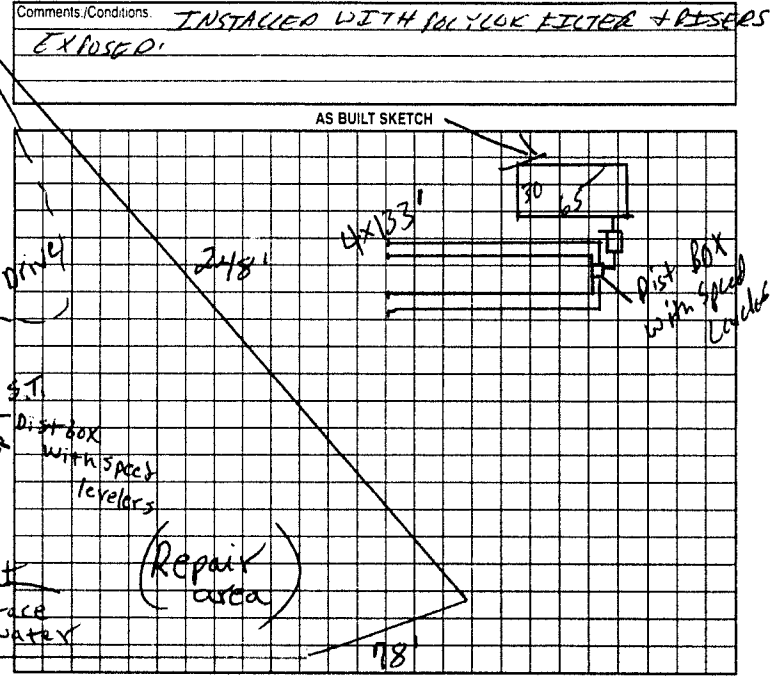

Permit can be suspended or revoked if any false information is supplied toward securing the permit/any unauthorized changes are made to the site/any unauthorized changes are made in the installation of the system. Improvement Permit with plat valid without expiration. Improvement Permit with site plan valid for sixty months. Authorization to Construct is valid for a period equal to that of Improvement Permit – not to exceed sixty months.

Signed: _____ date _____ Installed by: DALE FOX

Improvement Permit by: P.C. Moore date 2-17-00 Operation Permit by: Lee Cook REHS date 08-09-01

Authorization to Construct by: P.C. Moore date 2-17-00 Existing System Inspection by: _____ date _____

HEALTH DEPT. COPY: WHITE OWNER COPY (FINAL): YELLOW OWNER COPY (INITIAL): PINK