IREDELL COUNTY HEALTH DEPARTMENT

STATESVILLE 704-878-5305 MOORESVILLE 704-664-5281

IMPROVEMENT PERMIT / AUTHORIZATION TO CONSTRUCT / OPERATION PERMIT / EXISTING SYSTEM INSPECTION

PERMIT# 93717 PIN# 4756571999 DATE OP 7/9/01

OWNER OR CONTRACTOR JOSEPH [redacted] Crosswhite PHONE: Business Home 876-4357

ADDRESS 114 NANTUCKETT CT. MOORESVILLE NC 28115

LOCATION 2IN - TR SANE SOWERS - TL BAYMOUNT - TL BEECHAK - 2nd LOT ON LT

SUBDIVISION BAYMOUNT BLOCK / SECTION LOT 2 LOT AREA 1.28 AC SITE CLASS PS DESIGN FLOW 360GPD T.A.R. .256 0/R2

Septic Tank: 1000 Gallons: STB 1012 Date 12-24-00

Pump Tank: Gallons: PT Date

Pump Make: Model Serial No.

Nitrification Field: No Fields 1 Square Feet 1080 Linear Feet 360

No Lines 4 @ 90' Trench Width 36" Max Trench Bottom Depth 36" Gravel Depth MA

☑ New System ☐ Repair System Type: I, II, III, IV, V, VI

System Description: GravITY 25% REDUCTION

Repair System Description: LPP

Maintenance Agreement Required: ☐ Yes ☐ No

☐ Slab ☐ Crawl Space ☑ Basement w/plumbing ☐ Basement wo/plumbing

☐ House/Mod. Home No. Bedrooms 3

☐ Mobile Home No. Bathrooms 2

☐ Business No. Employees


☐ Other

Water Supply: ☐ Individual ☑ Public ☐ Community


Comments/Conditions:

Comments/Conditions: POLYLOK FILTER + MARKER. INSTALLED AS SHOWN

INITIAL SITE SKETCH 1" = 50'

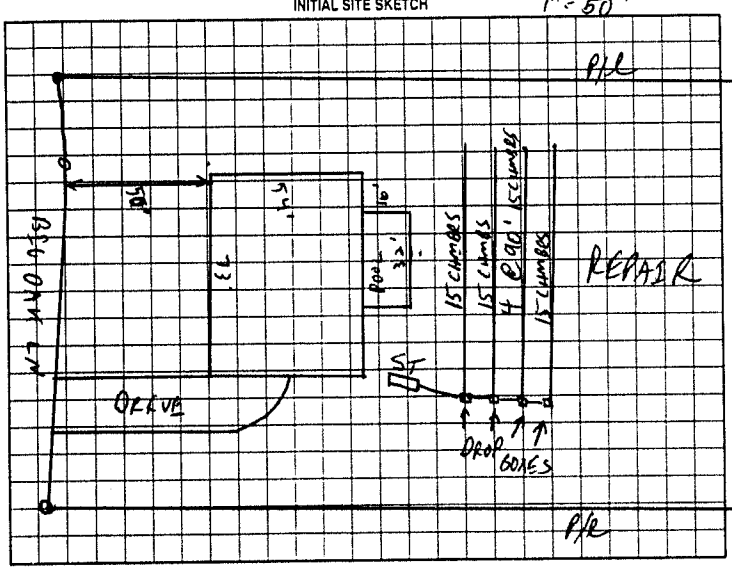

AS BUILT SKETCH

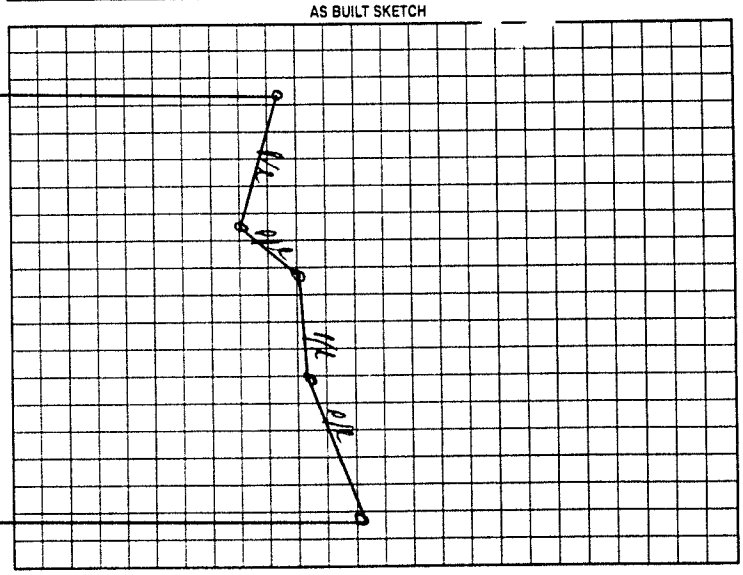

Permit can be suspended or revoked if any false information is supplied toward securing the permit/any unauthorized changes are made to the site/any unauthorized changes are made in the installation of the system. Improvement Permit with plat valid without expiration. Improvement Permit with site plan valid for sixty months. Authorization to Construct is valid for a period equal to that of Improvement Permit – not to exceed sixty months.

Signed: [signature] date 7-10-01

Improvement Permit by: C. [signature] RS date 7/9/01

Authorization to Construct by: C. [signature] RS date 7/9/01

Installed by: DAVID YOUNTZ

Operation Permit by: [signature] date 7-17-01

Existing System Inspection by: date

HEALTH DEPT COPY WHITE OWNER COPY (FINAL) YELLOW OWNER COPY (INITIAL) PINK