IREDELL COUNTY HEALTH DEPARTMENT

STATESVILLE 704-878-5305 MOORESVILLE 704-664-5281

IMPROVEMENT PERMIT / AUTHORIZATION TO CONSTRUCT / OPERATION PERMIT / EXISTING SYSTEM INSPECTION

PERMIT# 14969 PIN# 4756581182 DATE 9-28-07

OWNER OR APPLICANT Samson Brown PHONE: Business Home 764-500-0203

ADDRESS 105 Big Oak Lane

LOCATION 21 N to Pine Service Rd Baymont to west Baymont

SUBDIVISION Baymont BLOCK / SECTION LOT 1 LOT AREA 1.00ac SITE CLASS V DESIGN FLOW 480 L.T.A.R. .3

Septic Tank 1000 Gallons; ST# 1012 Date 11-29-99

Pump Tank: Gallons; PT Date

Pump Make: Model Serial No.

Nitrification Field: No Fields Square Feet 1600 Linear Feet 400

No. Lines 4 Trench Width 36" Max Trench Bottom Depth 36" Gravel Depth

☑ New System ☐ Repair ☐ Expansion System Type: I II III IV V VI

System Description: 25% GRAVITY

Repair System Description: 50% low Pressure

Maintenance Agreement Required: ☐ Yes ☐ No

☑ Gravity ☐ Pressure

☑ House/Mod. Home ☐ Mobile Home ☐ Business ☐ Other

No. Bedrooms 4 No. Persons No. Employees

Water Supply: ☐ Individual ☑ Public ☐ Community

☐ Slab ☐ Crawl Space ☑ Basement w/plumbing ☐ Basement wo/plumbing


Comments/Conditions:

Abandon Lines (1) and (2)
Reconnect tank to EXISTING
Line #3 add (2) new lines


Comments/Conditions:

Connect new lines to Line #1
New lines 25% each 100' long

INITIAL SITE SKETCH

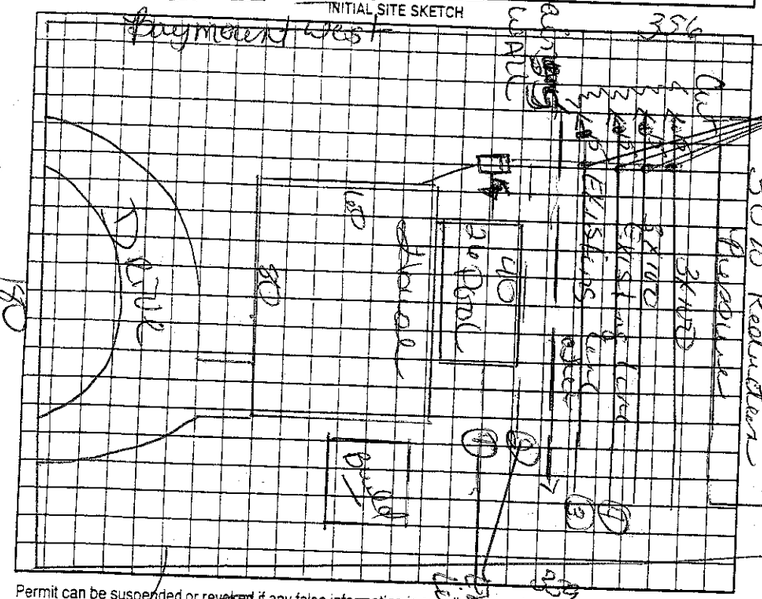

AS BUILT SKETCH

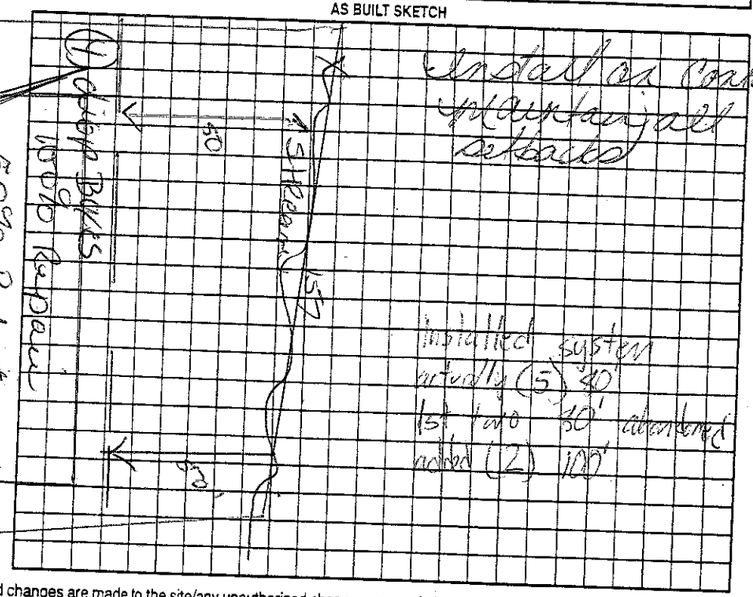


Permit can be suspended or revoked if any false information is supplied toward securing the permit/any unauthorized changes are made to the site/any unauthorized changes are made in the installation of the system. Improvement Permit with plat valid without expiration ☐ Improvement Permit with site plan valid for sixty months ☑ Authorization to Construct is valid for a period equal to that of Improvement Permit – not to exceed sixty months.

Signed: date 9-28-07

Improvement Permit by: Kelly Cook date 9-28-07

Authorization to Construct by: Kelly Cook date 9-28-07

Installed by: H1 Backhoe

Operation Permit by: date 2-28-08

Existing System Inspection by: date

HEALTH DEPT. COPY: WHITE OWNER COPY (FINAL): YELLOW OWNER COPY (INITIAL): PINK

105 Big Oak Lane