IREDELL COUNTY HEALTH DEPARTMENT

STATESVILLE 704-878-5305 MOORESVILLE 704-664-5281

IMPROVEMENT PERMIT / AUTHORIZATION TO CONSTRUCT / OPERATION PERMIT / EXISTING SYSTEM INSPECTION

PERMIT# 17963 PIN# 4756581182 DATE 3-17-99

OWNER OR CONTRACTOR Curt Gregory PHONE: Business Home 876 2532

ADDRESS 104 Bisoak Lane Statesville, N.C.

LOCATION Old mocksville Rd TL Jane Sowers TR Baymount TL west Baymount on L

SUBDIVISION Baymount West BLOCK / SECTION LOT 1 LOT AREA 1 acre SITE CLASS PS DESIGN FLOW 480 L.T.A.R. .3 Pastank

Septic Tank: 1000 Gallons; STB 1012 Date 11-2-99
Pump Tank: Gallons; PT Date
Pump Make: Model Serial No
Nitrification Field: No Fields 1 Square Feet 1200 Linear Feet 400
No Lines 5 Trench Width 36" Max Trench Bottom Depth 36" Gravel Depth N/A

New System / Repair System Type: I, II, III, IV, V, VI
System Description: Gravity 25% Red.
Repair System Description: " " "
Maintenance Agreement Required: Yes / No


House/Mod. Home No. Bedrooms 4
Mobile Home No. Bathrooms 3 1/2
Business No. Employees
Other
Slab / Crawl Space / Basement w/plumbing / Basement wo/plumbing

Water Supply: Individual / Public / Community


Comments/Conditions:

Comments/Conditions

INITIAL SITE SKETCH

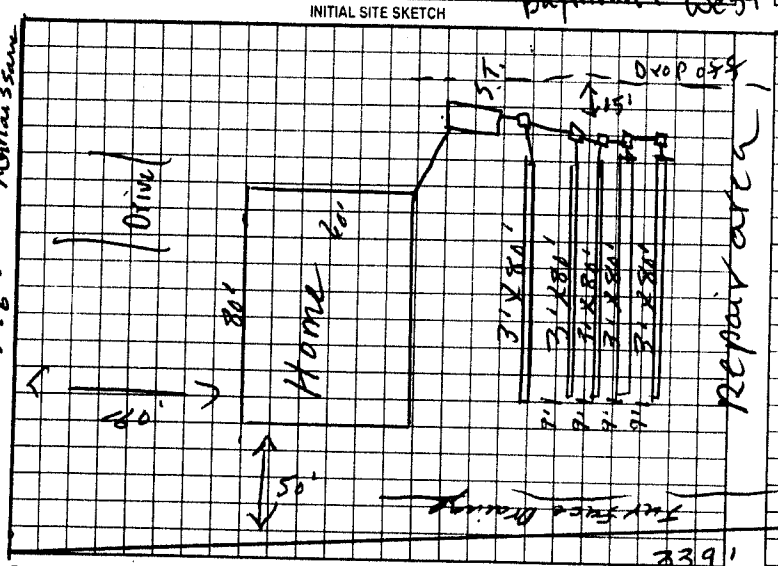

AS BUILT SKETCH

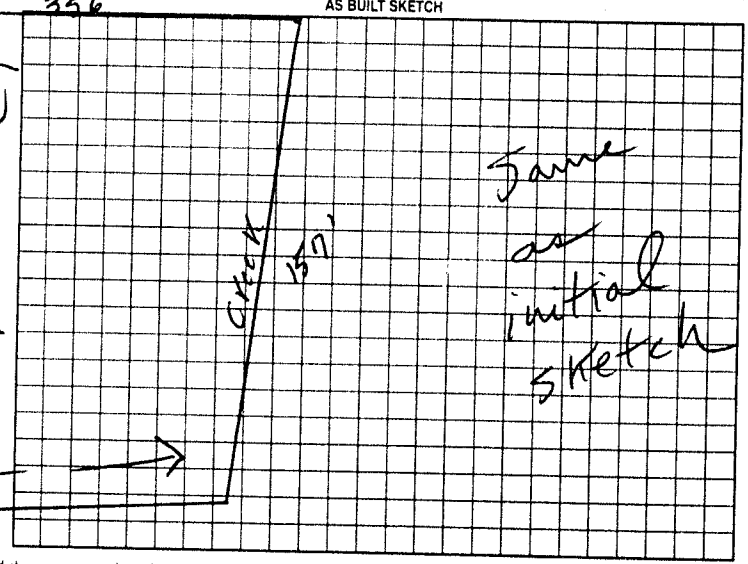

1076 Romaissance

Permit can be suspended or revoked if any false information is supplied toward securing the permit/any unauthorized changes are made to the site/any unauthorized changes are made in the installation of the system. Improvement Permit with plat valid without expiration. Improvement Permit with site plan valid for sixty months. Authorization to Construct is valid for a period equal to that of Improvement Permit – not to exceed sixty months.

Signed: date 6-2-99 Installed by: Tommy Frye

Improvement Permit by: R. C. Moore date 3-17-99 Operation Permit by: R. C. Moore date 2-23-00

Authorization to Construct by: R. C. Moore date 3-17-99 Existing System Inspection by: date

HEALTH DEPT. COPY. WHITE OWNER COPY (FINAL) YELLOW OWNER COPY (INITIAL) PINK