(I) 2:30

IREDELL COUNTY HEALTH DEPARTMENT

STATESVILLE 704-878-5305 MOORESVILLE 704-664-5281

IMPROVEMENT PERMIT / AUTHORIZATION TO CONSTRUCT / OPERATION PERMIT / EXISTING SYSTEM INSPECTION

PERMIT# 133808 PIN# 4756-58-5175 DATE 3-24-06

OWNER OR APPLICANT GREG DAVIS PHONE: Business 704-880-5603 Home 704-585-2251

ADDRESS 279 DRUMSTAND RD STONY PT NC 28678

LOCATION 21 N @ JANE SOWERS @ BAYMOUNT ON LEFT ON CORNER OF BAYMOUNT & WEST BAYMOUNT

SUBDIVISION BAYMOUNT BLOCK / SECTION ____ LOT 3 LOT AREA 1.422 SITE CLASS. PS DESIGN FLOW 480 L.T.A.R. .25

Septic Tank: 1000 Gallons; STB 1012 Date 3-19-07
Pump Tank: ____ Gallons; PT ____ Date ____
Pump Make: ____ Model ____ Serial No. ____
Nitrification Field: No Fields 1 Square Feet EA=1920' Linear Feet 480'
No Lines 5x96' Trench Width 36" Max Trench Bottom Depth 18"

☒ New System ☐ Repair ☐ Expansion System Type: I (II) III IV V VI
System Description: 60% 25% REDUCTION
Repair System Description: LP
Maintenance Agreement Required: ☐ Yes ☒ No

☒ House/Mod. Home ☐ Mobile Home ☐ Business ☐ Other
No. Bedrooms 4 No. Persons 8 No. Employees ____


Water Supply: ☐ Individual ☒ Public ☐ Community

Gravel Depth N/A ☒ Gravity ☐ Pressure ☐ Slab ☐ Crawl Space ☒ Basement w/plumbing ☐ Basement wo/plumbing

Comments/Conditions: ① 17% SLOPE = 18" TB ON SHALLOW SIDE & 25" TB ON HIGH SIDE. THIS MEANS FRONT DRAIN NEEDS TO BE 37" MINIMUM DEPTH WITH FALL TO DAYLIGHT ② INSTALL LINES ON CONTOURS ③ MAINTAIN SETBACKS

Comments/Conditions: ④ START AT NATURAL GRADE & DIG INTO HILL FOR BASEMENT CUT. START AT BALL STAKES

INITIAL SITE SKETCH

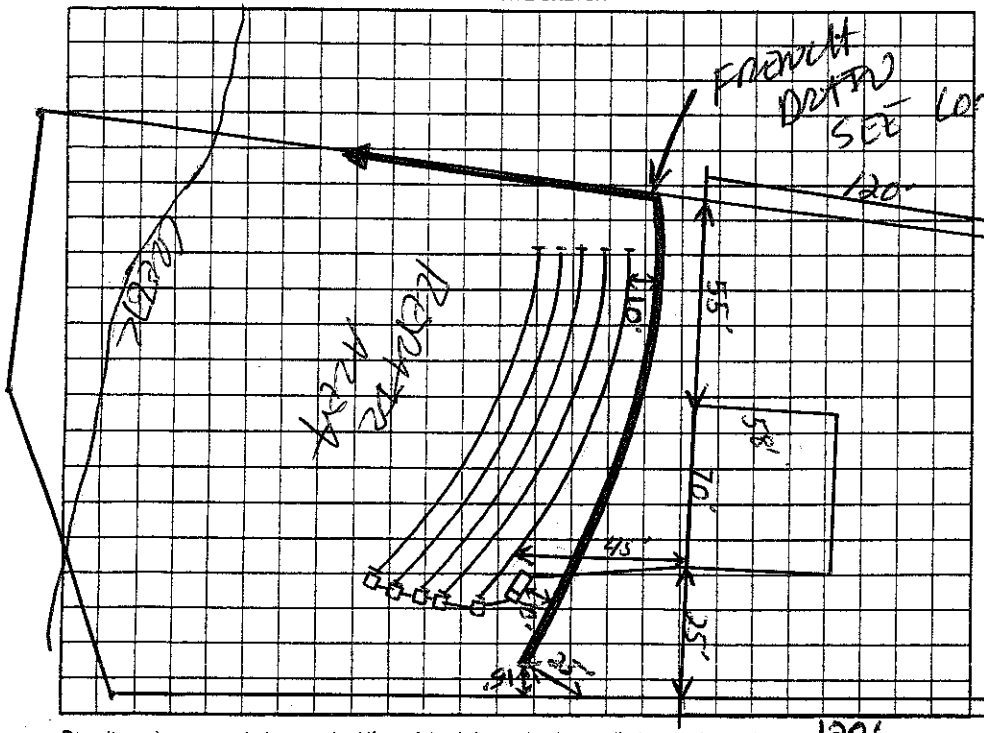

AS BUILT SKETCH

Permit can be suspended or revoked if any false information is supplied toward securing the permit, any unauthorized changes are made to the site/any unauthorized changes are made in the installation of the system. Improvement Permit with plat valid without expiration. ☐ Improvement Permit with site plan valid for sixty months ☐ Authorization to Construct is valid for a period equal to that of Improvement Permit – not to exceed sixty months.

Signed: Greg Davis date 6-5-06
Improvement Permit by: [signature] date 3-24-06
Authorization to Construct by: [signature] R.S. date 29 MAR 07
Installed by: Tommy Freye
Operation Permit by: [signature] date 9-26-07
Existing System Inspection by: ____ date ____

HEALTH DEPT. COPY: WHITE OWNER COPY (FINAL): YELLOW OWNER COPY (INITIAL): PINK