IREDELL COUNTY HEALTH DEPARTMENT

STATESVILLE 704-878-5305 MOORESVILLE 704-664-5281

IMPROVEMENT PERMIT / AUTHORIZATION TO CONSTRUCT / OPERATION PERMIT / EXISTING SYSTEM INSPECTION

PERMIT# 131677 PIN# 4756 59 7852 DATE 10-25-05

OWNER OR CONTRACTOR Joey Eldridge PHONE: Business Home 704 902 0167

ADDRESS 261 Baymount Drive

LOCATION Hwy 21 (R) on Jane Sowers Rd, (L) on Country - 1st lot on (R)

SUBDIVISION Baymount BLOCK / SECTION LOT LOT AREA 1.565 Ac. SITE CLASS. PS DESIGN FLOW 360 L.T.A.R. .3

Septic Tank: 1000 Gallons; STB 1012 Date 82905
Pump Tank: Gallons; PT Date
Pump Make: Model Serial No.
Nitrification Field: No Fields 1 Square Feet 1200 Linear Feet 300
No Lines 3 Trench Width 3 Max Trench Bottom Depth 36 Gravel Depth

[X] New System [ ] Repair System Type: I (II) III IV V VI
System Description: 25% Reduction-Gravity
Repair System Description: 25% Reduction-Gravity Liner
Maintenance Agreement Required: [ ] Yes [X] No

[X] House/Mod. Home No. Bedrooms 3
[ ] Mobile Home No. Bathrooms
[ ] Business No. Employees
[ ] Other


[ ] Slab [X] Crawl Space [ ] Basement w/plumbing [ ] Basement wo/plumbing

Water Supply: [ ] Individual [X] Public [X] Community


Comments:/Conditions:

Comments:/Conditions: Interceptor Drain
Yellow tuf-tite filter
Septic tank liner

INITIAL SITE SKETCH

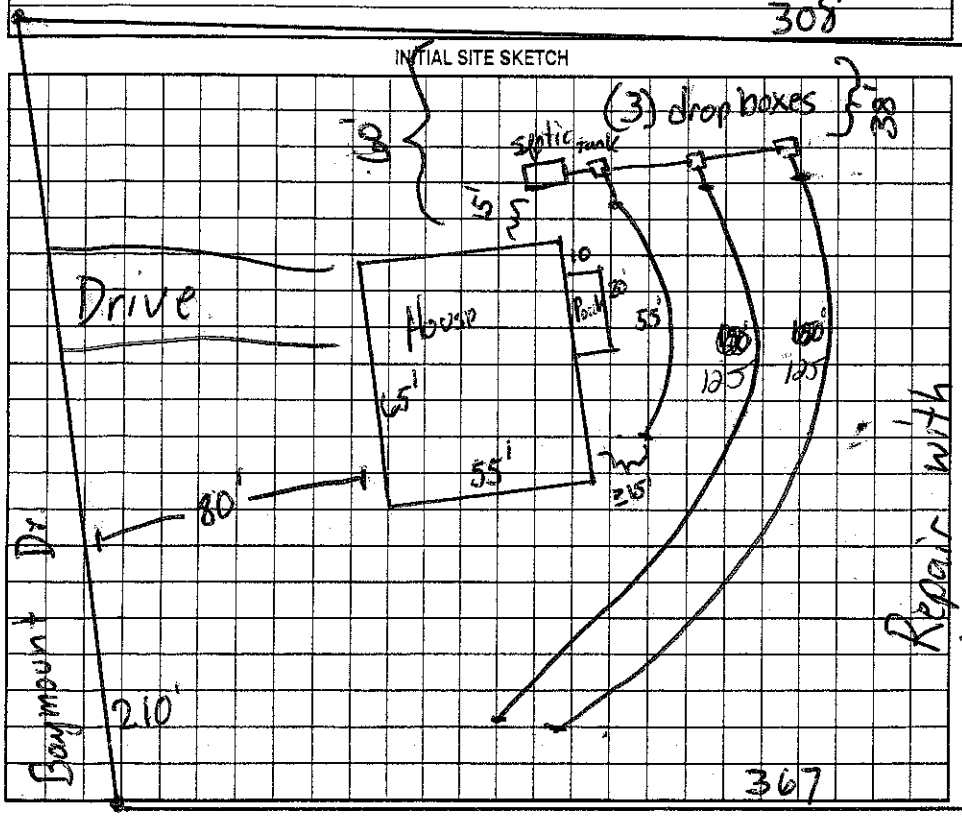

AS BUILT SKETCH

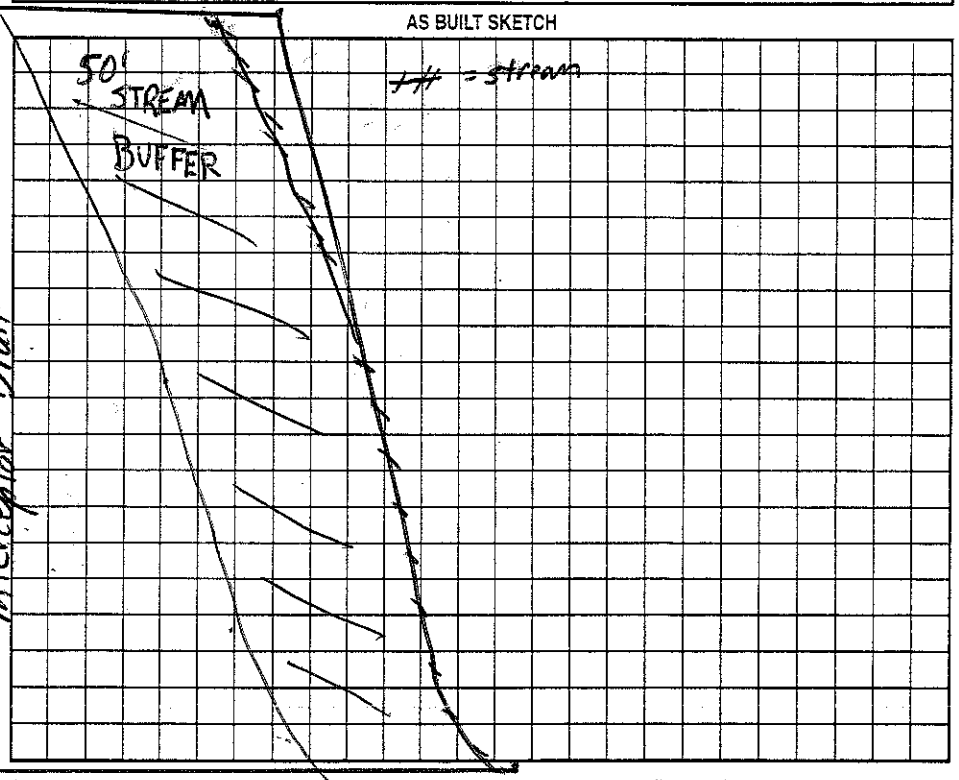

Permit can be suspended or revoked if any false information is supplied toward securing the permit/any unauthorized changes are made to the site/any unauthorized changes are made in the installation of the system. Improvement Permit with plat valid without expiration. Improvement Permit with site plan valid for sixty months. Authorization to Construct is valid for a period equal to that of Improvement Permit – not to exceed sixty months.

Signed: James Stevens date 10-25-05 Installed by: Craig Thompson

Improvement Permit by: James Stevens date 10-25-05 Operation Permit by: Kelly Cox date 4-10-06

Authorization to Construct by: James Stevens date 10-28-05 Existing System Inspection by: date

HEALTH DEPT. COPY: WHITE OWNER COPY (FINAL): YELLOW OWNER COPY (INITIAL): PINK