
~ 92 NO REPAIR DONE

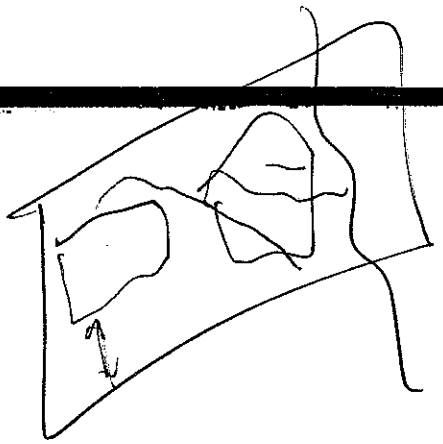

IREDELL COUNTY HEALTH DEPARTMENT

STATESVILLE 704-878-5305 MOORESVILLE 704-664-5281

IMPROVEMENT PERMIT / CERTIFICATE OF COMPLETION / OPERATION PERMIT / EXISTING SYSTEM INSPECTION

PROPERTY DESCRIPTION NO. 69024 DATE 8-22-97 TAX MAP NO 4756.53.9206 Watershed [ ] Yes [ ] No

OWNER OR CONTRACTOR Marguerite massey PHONE: Business Home 871 9997

ADDRESS 122 New Mexico Dr. Sta

LOCATION 64E TL old mocksville RS TL Brookview TR New Mexico Dr. cross stream 1st mail rt.

SUBDIVISION Country Sites BLOCK / SECTION LOT 194 LOT AREA 15x45' SITE CLASS PS DESIGN FLOW 240 LTAR

Septic Tank: Gallons; STB Date

Pump Tank: Gallons; PT Date

Pump Make: Model Serial No

Nitrification field: No Fields Square Feet Linear Feet

No Lines Trench Width Max Trench Bottom Depth Gravel Depth

[ ] New System [ ] Repair System Type [ ] I [ ] II [ ] III [ ] IV [ ] V

System Description:

Repair System Description

Maintenance Agreement Required Yes No

Slab Crawl Space Basement w/plumbing Basement wo/plumbing

House/Mod Home No Bedrooms 2

Mobile Home No Bathrooms 2

Business No Employees

Other


Water Supply: [ ] Individual [ ] Community [ ] Public

Comments:

Comments:

INITIAL SITE SKETCH

AS BUILT SKETCH

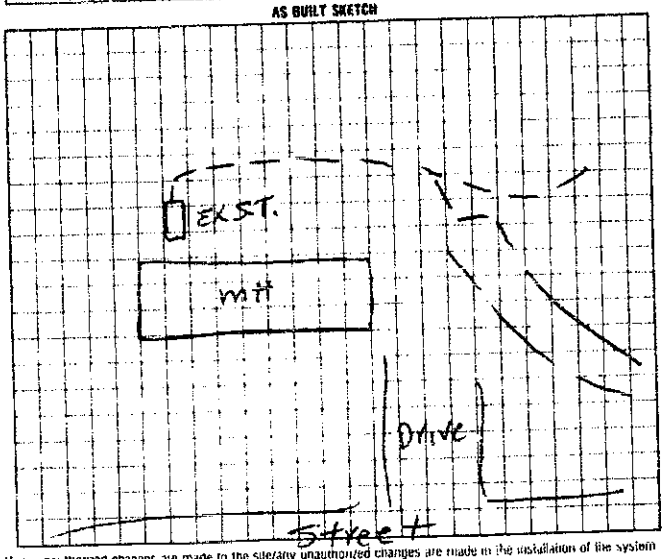

I understand that this permit can be suspended or revoked if any false information is supplied toward securing the permit; unauthorized changes are made to the site; any unauthorized changes are made in the installation of the system. Improvement Permit is valid for 60 months from date of issuance

Signed: Installed by Andy Daniels

Improvement Permit by: date Certificate of Completion by date 2-6-95

Existing System Inspection by: C. Moore date 8-22-97 Operation Permit by Steve Hedrick date

HEALTH DEPT. COPY WHITE INSPECTION COPY (FINAL) GREEN OWNER COPY (FINAL) YELLOW INSPECTION COPY (INITIAL) PINK OWNER COPY (INITIAL) GOLD

World Head works
2275 Pumpkin Road
Pineola, NC 28662

JLS / JC
755 Washington St JC Sweet
Statesville, NC 28677 OLS

Will
Irvin Clark
873-2547

JAN. 9, 1989 19:11