IREDELL COUNTY HEALTH DEPARTMENT

Statesville Phone TR 3-7271 Mooresville Phone NO 3-1271

PERMIT TO INSTALL SEPTIC TANK

Permit No. 71 Permit Date Nov. 13 1972

Owner M+J Sales Address Statesville

Installed By Harlan Lackey Address Stony Point


Location of Property Brook Mead Trailer Park off old Mocksville Road. Last Trailer on Right at end of Strut.

Tank		Capacity		Length of Lines		Fixtures	
Block	( )	1000	(✓)	225'	(✓)	No. of Baths	(1)
Precast	(✓)	1250	( )	250'	( )	Dishwasher	( )
		1500	( )	Other_____		Garbage Grdr.	( )
		Other_____				Other_____	

NOTIFY HEALTH DEPARTMENT AT LEAST EIGHT HOURS BEFORE TANK IS TO BE INSPECTED.

Final Inspection_____19___ Approved ( ) Disapproved ( )

Remarks_____

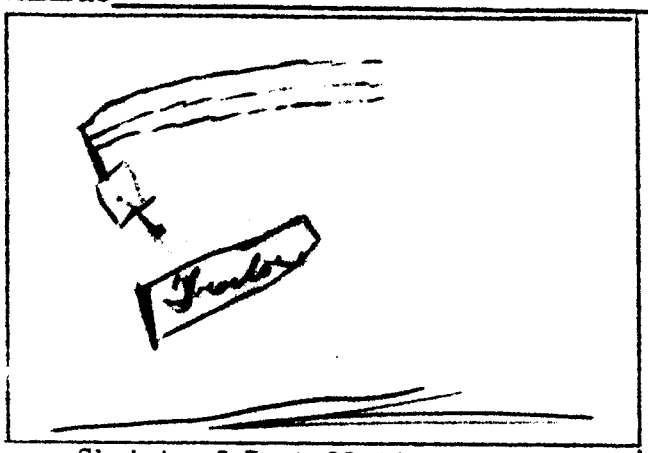

Sketch of Installation

No Final Inspection.

Sanitarian