IREDELL COUNTY HEALTH DEPARTMENT

STATESVILLE 704-878-5305 MOORESVILLE 704-664-5281

IMPROVEMENT PERMIT / AUTHORIZATION TO CONSTRUCT / OPERATION PERMIT / EXISTING SYSTEM INSPECTION

PERMIT# 87354 PIN# 4756667939 DATE 1-12-00

OWNER OR CONTRACTOR Rick Wilson Custom Homes PHONE: Business 8380491 Home

ADDRESS 3325 Winchester Ln Statesville, N.C.

LOCATION Off Mocksville Tr. Jane Sowers Tr Stone House 1st lot left

SUBDIVISION ~~Baymount~~ Stonerise Sec. BLOCK / SECTION LOT 115 LOT AREA 1.97 acres SITE CLASS PS DESIGN FLOW 360 L.T.A.R. .3

Septic Tank: 1000 Gallons; STB 1012 Date 5-13-00

Pump Tank: Gallons; PT Date

Pump Make: Model Serial No

Nitrification Field: No Fields 1 Square Feet 900 Linear Feet 300

No Lines 6 Trench Width 3'6" Max Trench Bottom Depth 36" Gravel Depth N/A

☑ New System ☐ Repair System Type: I. II. III. IV. V. VI

System Description: Gravity 2520 Rebuilt

Repair System Description: Pump To Conv.

Maintenance Agreement Required: ☐ Yes ☑ No

☑ House/Mod. Home ☐ Mobile Home ☐ Business ☐ Other

No. Bedrooms 3 No. Bathrooms 2½ No. Employees


☐ Slab ☑ Crawl Space ☐ Basement w/plumbing ☐ Basement wo/plumbing

Water Supply: ☐ Individual ☑ Public ☐ Community

Comments:/Conditions:


Jane Sowers

INITIAL SITE SKETCH 231

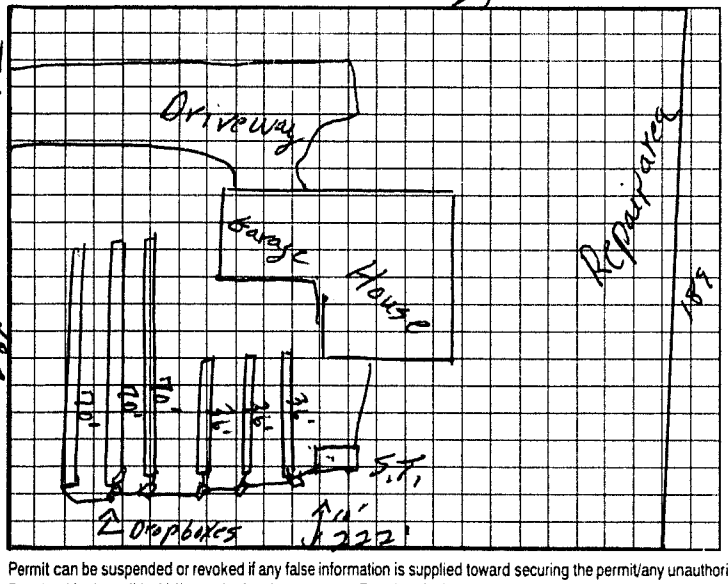

Comments:/Conditions: SEPTIC TANK WITH RISERS AND MARKER INSTALLED ~~AC~~ USING "POLY LOK" FILTER

AS BUILT SKETCH

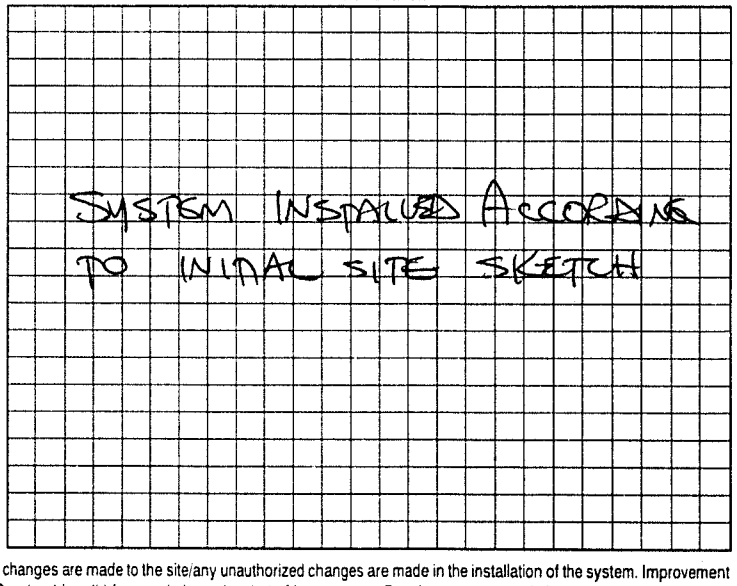

Permit can be suspended or revoked if any false information is supplied toward securing the permit/any unauthorized changes are made to the site/any unauthorized changes are made in the installation of the system. Improvement Permit with plat valid without expiration. Improvement Permit with site plan valid for sixty months. Authorization to Construct is valid for a period equal to that of Improvement Permit – not to exceed sixty months.

Signed: Rick Wilson Jr. date 1/18/00

Improvement Permit by: P.C. Moore date 1-12-00

Authorization to Construct by: P.C. Moore date 1-12-00

Installed by: A-1 Backhoe

Operation Permit by: Steve Herrick date 7-28-00

Existing System Inspection by: date

HEALTH DEPT. COPY: WHITE OWNER COPY (FINAL): YELLOW OWNER COPY (INITIAL): PINK