IREDELL COUNTY HEALTH DEPARTMENT - *ENVIRONMENTAL HEALTH* ☒ STATESVILLE OFFICE 704-878-5305 ☐ MOORESVILLE OFFICE 704-664-5281

IMPROVEMENT PERMIT / AUTHORIZATION TO CONSTRUCT / OPERATION PERMIT / EXISTING SYSTEM INSPECTION

PERMIT # 167058 PIN # 4756-66-8680 DATE 9-19-11

OWNER Gary Cuzard APPLICANT: PHONE: Home/Cell # 704-876-4211 Business #

SITE ADDRESS 126 Greenfield Drive - West OWNER / APPLICANT ADDRESS

SITE DIRECTIONS Old Mocksville Rd, 2 miles N from I-40, (L) on Jane Sowers, (L) on Tracy, (R) on Greenfield Dr. W, house on (R) in circle

SUBDIVISION Grandview BLOCK / SECTION LOT # 35 LOT AREA DESIGN FLOW L.T.A.R.

Septic Tank existing Gallons: STB existing Date

Pump Tank Gallons: P T Date

Pump Make Model Serial #

No. Nitrification Fields: 1 No. Lines 3 Linear Feet 400

Trench Width 36" Max. Trench Bottom Depth 8± Gravel Depth 8±

☐ New System ☐ Repair ☐ Expansion System Type I (II) III IV V VI

System Description: existing Conventional Gravity

Repair System Description:

Maintenance Agreement Required ☐ YES ☐ NO

☒ GRAVITY ☐ PRESSURE

☒ Residence No. Bedrooms 3

☐ Business No. Persons

☐ Other No. Employees

☐ Slab ☒ Crawl Space

☐ Basement w/plumbing ☐ Basement w/o plumbing


Water Supply: ☐ Private ☒ Public ☐ Community

Comments / Conditions

Adding Dining room and Sunroom

INITIAL SITE SKETCH

AS BUILT SKETCH 1" = 50'

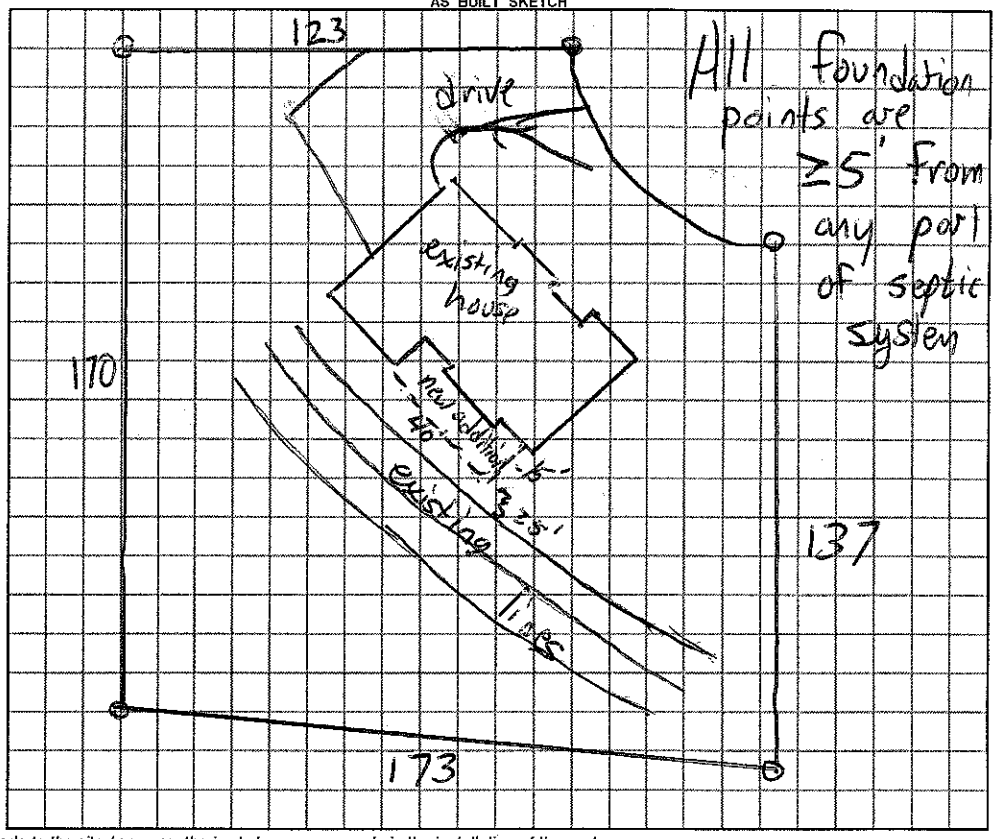

Permit can be suspended or revoked if any false information is supplied toward securing the permit / any unauthorized changes are made to the site / any unauthorized changes are made in the installation of the system.

☐ ***IMPROVEMENT PERMIT*** with plat valid without expiration. ☒ ***IMPROVEMENT PERMIT*** with ~~plat valid without expiration~~ site plan valid 60 mo. ☐ ***AUTHORIZATION TO CONSTRUCT*** valid for period equal to IMPROVEMENT PERMIT--not to exceed 60 mo.

Owner / Applicant Signature: Ricky Dyson (contractor) Date 10-21-11 Installed by:

IMPROVEMENT PERMIT by: REHS Date OPERATION PERMIT by: REHS Date

AUTHORIZATION TO CONSTRUCT by: REHS Date Existing System Inspected by: REHS Date 9-19-11

YOU SHOULD CONTACT A LOCATOR SERVICE PRIOR TO ANY EXCAVATION

White Copy -- Environmental Health YELLOW COPY (Final) Owner / Applicant PINK COPY (Initial) Owner / Applicant