0004671

IREDELL COUNTY HEALTH DEPARTMENT

STATESVILLE 704-878-5305 MOORESVILLE 704-664-5281

l.i.c 50996

IMPROVEMENT PERMIT / CERTIFICATE OF COMPLETION / OPERATION PERMIT / EXISTING SYSTEM INSPECTION

PROPERTY DESCRIPTION NO. 18210 DATE 4-7-94 TAX MAP NO. 106-7-A-2A Watershed: ☐ Yes ☑ No

OWNER OR CONTRACTOR Doris Crouch PHONE: Business _____ Home 910-292-4340

ADDRESS 420 Whippoorwill Greensboro N.C.

LOCATION 21 N TR Jane Sowers 1ST Ent. To Baymount 1st lot on left

SUBDIVISION Baymount BLOCK / SECTION _____ LOT 31 LOT AREA .689 acres SITE CLASS. PS DESIGN FLOW 360 L.T.A.R. 1.35

Septic Tank: 1000 Gallons; STB 1012 Date 6/12/94

Pump Tank: _____ Gallons; PT _____ Date _____

Pump Make: _____ Model _____ Serial No. _____

Nitrification Field: No Fields 1 Square Feet 1080 Linear Feet 360

No Lines 4 Trench Width 36" Max Trench Bottom Depth 36" Gravel Depth 12"

☑ New System ☐ Repair System Type: I (II) III, IV, V, VI

System Description: Con Gravity

Repair System Description: " "

Maintenance Agreement Required: ☐ Yes ☑ No

☑ House/Mod. Home No. Bedrooms 3

☐ Mobile Home No. Bathrooms 2½

☐ Business No. Employees _____

☐ Other _____


☐ Slab ☑ Crawl Space ☐ Basement w/plumbing ☐ Basement wo/plumbing

Water Supply: ☐ Individual ☐ Community ☑ Public

Comments:

Comments:

INITIAL SITE SKETCH

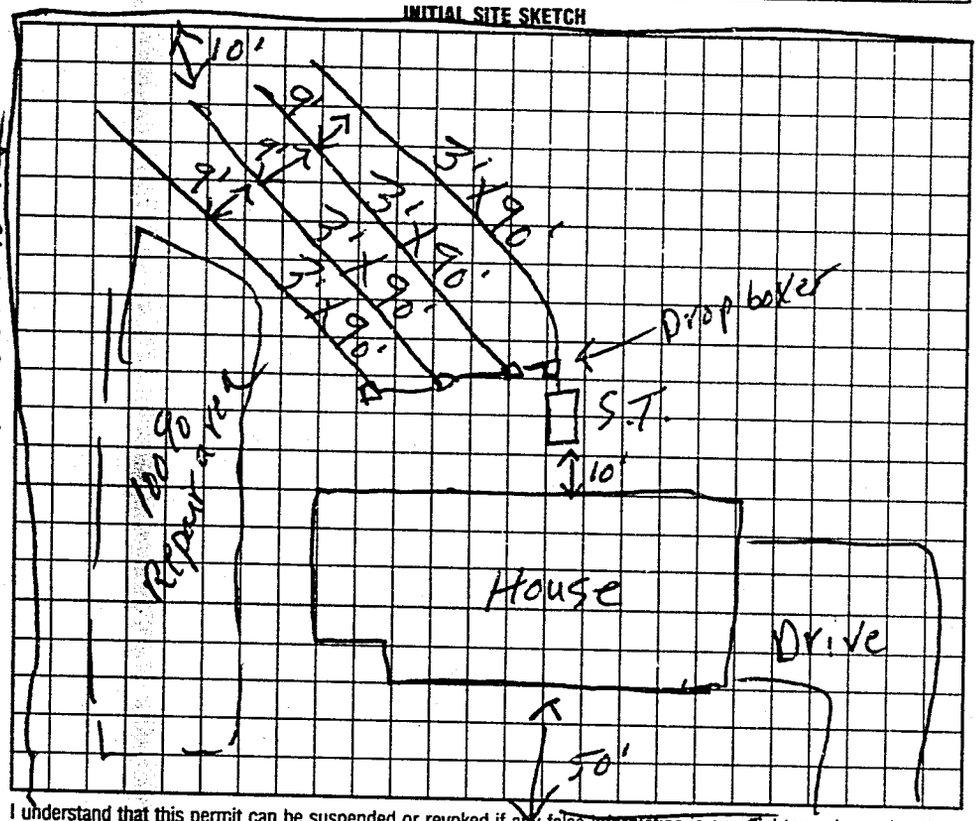

AS BUILT SKETCH

SYSTEM INSTALLED ACCORDING TO INITAL SITE SKETCH

I understand that this permit can be suspended or revoked if any false information is supplied toward securing the permit/any unauthorized changes are made to the site/any unauthorized changes are made in the installation of the system. Improvement Permit is valid for 60 months from date of issuance.

Signed: X Ray B Warren

Improvement Permit by: D. C. Moore date 4-11-94

Existing System Inspection by: _____ date _____

Installed by: Tommy Frye

Certificate of Completion by: Steve Hedrick date 12/9/94

Operation Permit by: _____ date _____

HEALTH DEPT. COPY: WHITE INSPECTION COPY (FINAL): GREEN OWNER COPY (FINAL): YELLOW INSPECTION COPY (INITIAL): PINK OWNER COPY (INITIAL): GOLD