IREDELL COUNTY HEALTH DEPARTMENT

THIS PERMIT REPLACES PREVIOUS ISSUED 8-12-04

STATESVILLE 704-878-5305 (C1) MOORESVILLE 704-664-5281

IMPROVEMENT PERMIT / AUTHORIZATION TO CONSTRUCT / OPERATION PERMIT / EXISTING SYSTEM INSPECTION

(C1)

PERMIT# 123195 PIN# 4756-67-4964 DATE 8-16-04

OWNER OR CONTRACTOR ~~KENT R. HICKS~~ DANNY ASHCRAFT PHONE: Business 704-608-8266 Home 704-872-3718

ADDRESS 40 528 MOCKSVILLE HWY STATESVILLE NC 28625

LOCATION US 21 NORTH, TR JANE SOWERS RD, TL BAYMOUNT DR TR CRABAPPLE LANE 1ST LOT ON LEFT

SUBDIVISION BAYMOUNT MEADOWS BLOCK / SECTION 125 LOT ~~107~~ LOT AREA 0.871 ACRE SITE CLASS PS DESIGN FLOW 480 L.T.A.R. 0.356 GPD/FT

Septic Tank: 1000 Gallons; STB 794 Date 8-8-04

Pump Tank: _____ Gallons; PT _____ Date _____

Pump Make: _____ Model _____ Serial No. _____

Nitrification Field: No Fields 1 Square Feet 690 Linear Feet 230

No Lines TWO Trench Width 36" Max Trench Bottom Depth 36" Gravel Depth 12"

☑ New System ☐ Repair System Type: I (II) III, IV, V, VI

System Description: CONVENTIONAL GRAVITY

Repair System Description: 25% REDUCTION, LOW PRESSURE

Maintenance Agreement Required: ☐ Yes ☑ No

☑ House/Mod. Home No. Bedrooms 4

☐ Mobile Home No. Bathrooms _____

☐ Business No. Employees _____

☐ Other _____


☐ Slab ☑ Crawl Space ☐ Basement w/plumbing ☐ Basement wo/plumbing

Water Supply: ☐ Individual ☑ Public ☐ Community

Comments:/Conditions: (1) CRUSH & FILL EXISTING SEPTIC TANK W/ CLAY (2) EXPAND SYSTEM AS SHOWN W/ NEW SEPTIC TANK, TWO ADDITIONAL LINES TYING INTO EXISTING LINES W/ DROP BOXES FOR SERIAL DISTRIBUTION.

Comments:/Conditions: SEPTIC TANK WITH MARKER INSTALLED USING "RED POLYLOK" FILTER

INITIAL SITE SKETCH

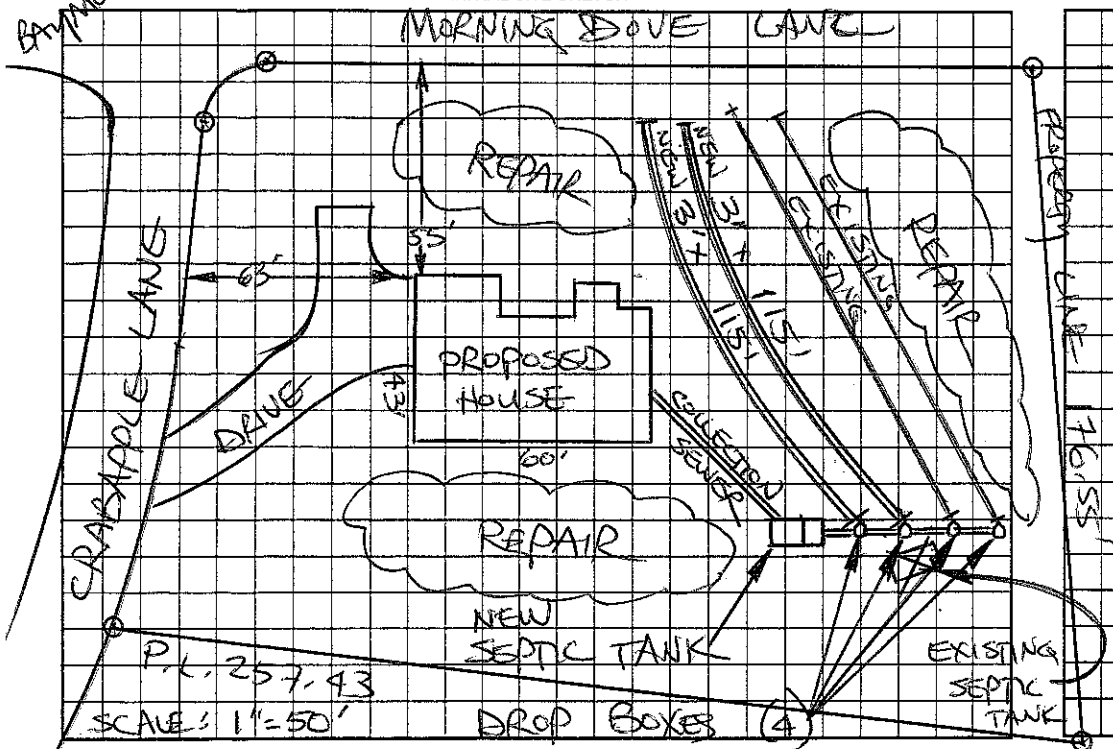

AS BUILT SKETCH

SYSTEM EXPANDED ACCORDING TO INITIAL SITE SKETCH

Permit can be suspended or revoked if any false information is supplied toward securing the permit/any unauthorized changes are made to the site/any unauthorized changes are made in the installation of the system. Improvement Permit with plat valid without expiration. Improvement Permit with site plan valid for sixty months. Authorization to Construct is valid for a period equal to that of Improvement Permit – not to exceed sixty months.

Signed: Jennifer Ashcraft date 8/16/04

Improvement Permit by: STEVE HEDRICK date 8-16-04

Authorization to Construct by: STEVE HEDRICK date 8-16-04

Installed by: SHAWN PENNINGTON

Operation Permit by: STEVE HEDRICK date 8-8-04

Existing System Inspection by: _____ date _____

HEALTH DEPT. COPY: WHITE OWNER COPY (FINAL): YELLOW OWNER COPY (INITIAL): PINK