IREDELL COUNTY HEALTH DEPARTMENT

STATESVILLE 704-878-5305 MOORESVILLE 704-664-5281 (4)

IMPROVEMENT PERMIT / AUTHORIZATION TO CONSTRUCT / OPERATION PERMIT / EXISTING SYSTEM INSPECTION

PERMIT# 123195 PIN# 4756-67-4964 DATE 8-12-04

OWNER OR CONTRACTOR KENT R. HOKE PHONE: Business 704-878-9289 Home 704-880-0322

ADDRESS 528 MOCKSVILLE HWY STATESVILLE NC 28625

LOCATION US 21 NORTH, TR JANE SOWERS RD, TL BAYMOUNT DRIVE, TR CRABAPPLE LANE 1ST LOT ON LEFT

SUBDIVISION BAYMOUNT BLOCK / SECTION ____ LOT 151 LOT AREA 0.871 ACRE SITE CLASS. DS DESIGN FLOW 360 L.T.A.R. 0.5 GPD/FT² (EXISTING)

Septic Tank: 1000 Gallons; STB ____ Date ____

Pump Tank: ____ Gallons; PT ____ Date ____

Pump Make: ____ Model ____ Serial No. ____

Nitrification Field: No Fields 1 Square Feet 720 Linear Feet 240

No Lines TWO Trench Width 36" Max Trench Bottom Depth 36" Gravel Depth 12"

☐ New System ☐ Repair System Type: I, (II), III, IV, V, VI

System Description: CONVENTIONAL (EXISTING)

Repair System Description: ____

Maintenance Agreement Required: ☐ Yes ☒ No

☒ House/Mod. Home No. Bedrooms 3

☐ Mobile Home No. Bathrooms ____

☐ Business No. Employees ____

☐ Other ____


☐ Slab ☒ Crawl Space ☐ Basement w/plumbing ☐ Basement wo/plumbing

Water Supply: ☐ Individual ☒ Public ☐ Community


Comments:/Conditions: BAYMOUNT DRIVE

Comments:/Conditions: SYSTEM UNDERSIZED ACCORDING TO TODAY'S STANDARDS

INITIAL SITE SKETCH

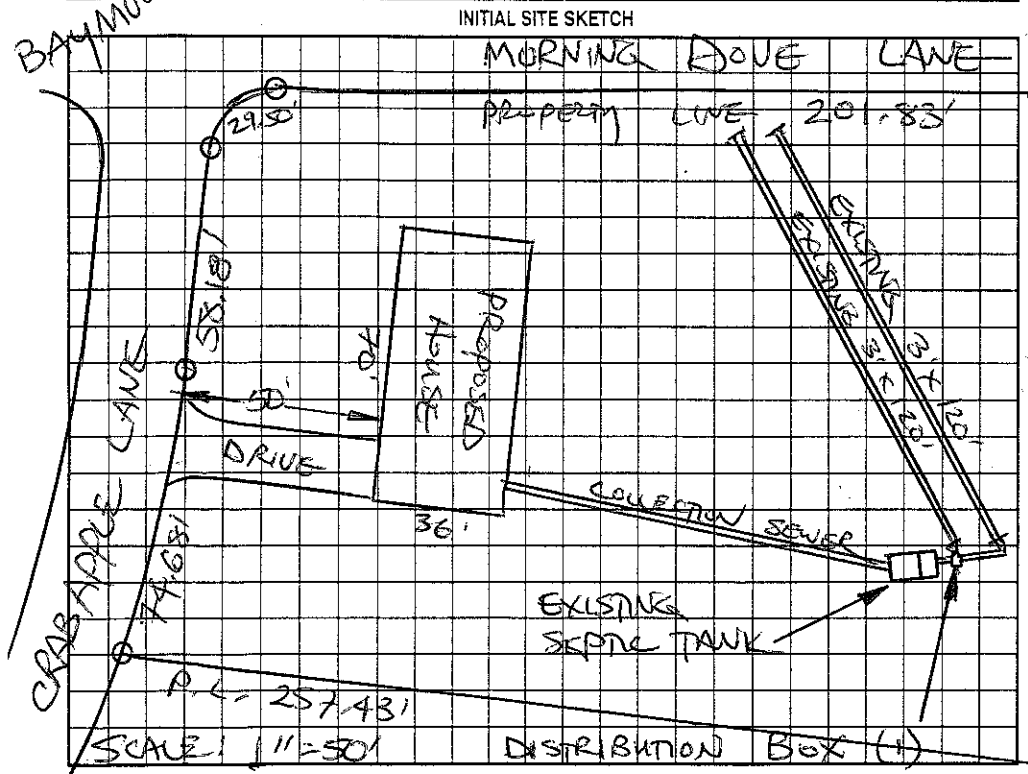

AS BUILT SKETCH

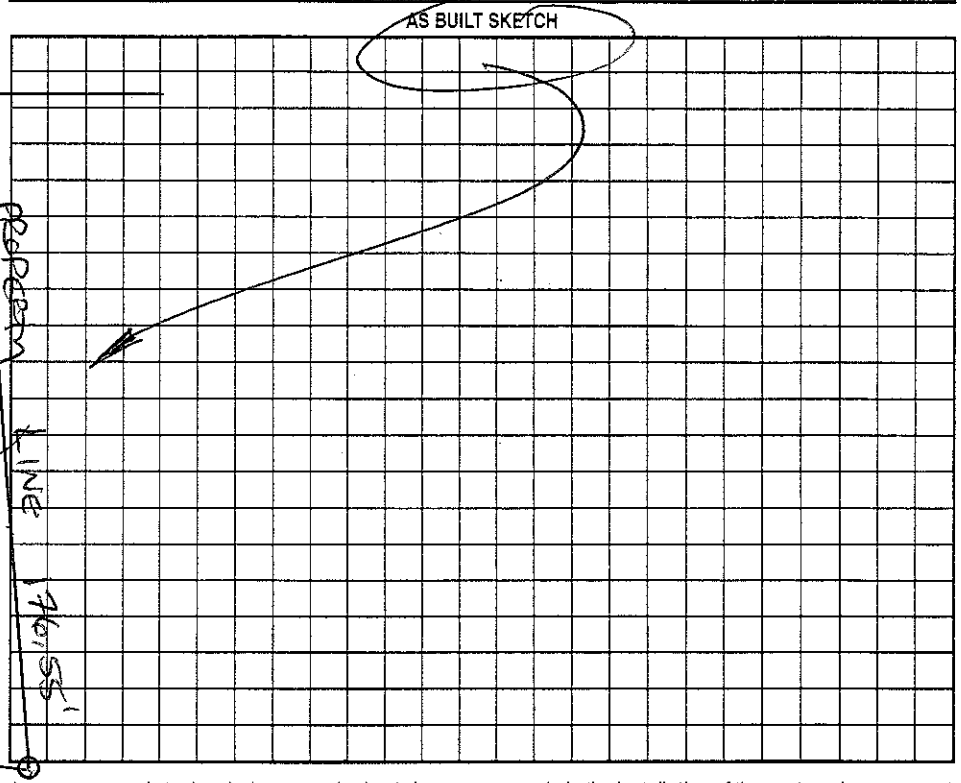

Permit can be suspended or revoked if any false information is supplied toward securing the permit/any unauthorized changes are made to the site/any unauthorized changes are made in the installation of the system. Improvement Permit with plat valid without expiration. Improvement Permit with site plan valid for sixty months. Authorization to Construct is valid for a period equal to that of Improvement Permit – not to exceed sixty months.

Signed: ____ date ____ Installed by: ____

Improvement Permit by: ____ date ____ Operation Permit by: ____ date ____

Authorization to Construct by: ____ date ____ Existing System Inspection by: STEVE HEDRICK date 8-12-04

HEALTH DEPT. COPY: WHITE OWNER COPY (FINAL): YELLOW OWNER COPY (INITIAL): PINK