IREDELL COUNTY HEALTH DEPARTMENT

THIS PERMIT VOIDS PREVIOUS ISSUED 7-10-2002

STATESVILLE 704-878-5305 (C1) MOORESVILLE 704-664-5281

IMPROVEMENT PERMIT / AUTHORIZATION TO CONSTRUCT / OPERATION PERMIT / EXISTING SYSTEM INSPECTION

PERMIT# 107303 PIN# 4756-67-5513 DATE 9-8-04

OWNER OR CONTRACTOR BRIAN & JILIAN PESTOTNIK PHONE: Business 704-872-0271 Home 336-782-9262

ADDRESS 130 VICTORY LANE, STATESVILLE, NC 28625

LOCATION US 21 NORTH, TR JANE SOWERS ROAD, TL BAYMOUNT DRIVE, 4th LOT ON RIGHT

SUBDIVISION BAYMOUNT BLOCK / SECTION ____ LOT 121 LOT AREA 0.970 ACRE SITE CLASS PS1 DESIGN FLOW 480 L.T.A.R. 0.30 GPD/FT2

Septic Tank: 1000 Gallons; STB 1012 Date 3-25-05
Pump Tank: ____ Gallons; PT ____ Date ____
Pump Make: ____ Model GP 50 Serial No. 100
Nitrification Field: No Fields 1 Square Feet 1600 Linear Feet 533
No Lines FOUR 3 Trench Width 36" Max Trench Bottom Depth 36" Gravel Depth 12"

☑ New System ☐ Repair System Type: I, II, III, IV, V, VI
System Description: CONVENTIONAL GRAVITY
Repair System Description: 25% REDUCTION, GRAVITY
Maintenance Agreement Required: ☐ Yes ☑ No


☑ House/Mod. Home No. Bedrooms 4
☐ Mobile Home No. Bathrooms ____
☐ Business No. Employees ____
☐ Other ____
☐ Slab ☑ Crawl Space ☐ Basement w/plumbing ☐ Basement wo/plumbing

Water Supply: ☐ Individual ☑ Public ☐ Community


Comments:/Conditions: ① INSTALL LINES ON CONTOUR AS FLAGGED.
② REMOVE EXISTING OLD ROADBED AT REAR OF LOT.

Comments:/Conditions: SEPTIC TANK WITH MARKER INSTALLED. USING "TUFTITE" FILTER. HOUSE HAS BASEMENT = POOR SITING

INITIAL SITE SKETCH

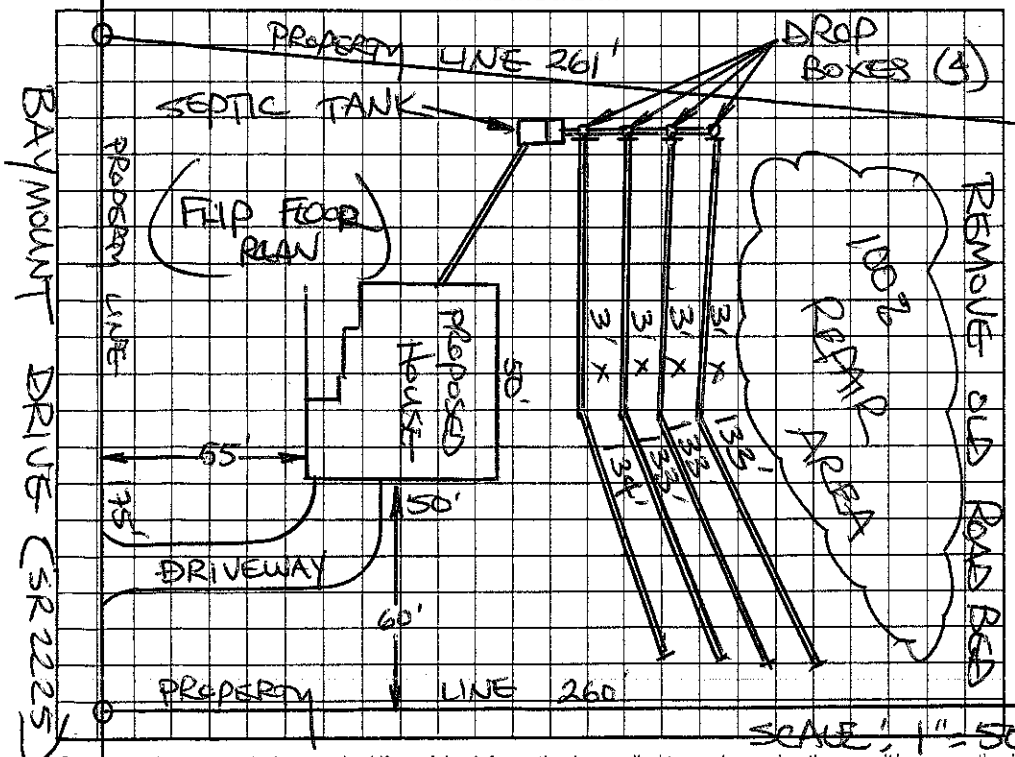

AS BUILT SKETCH

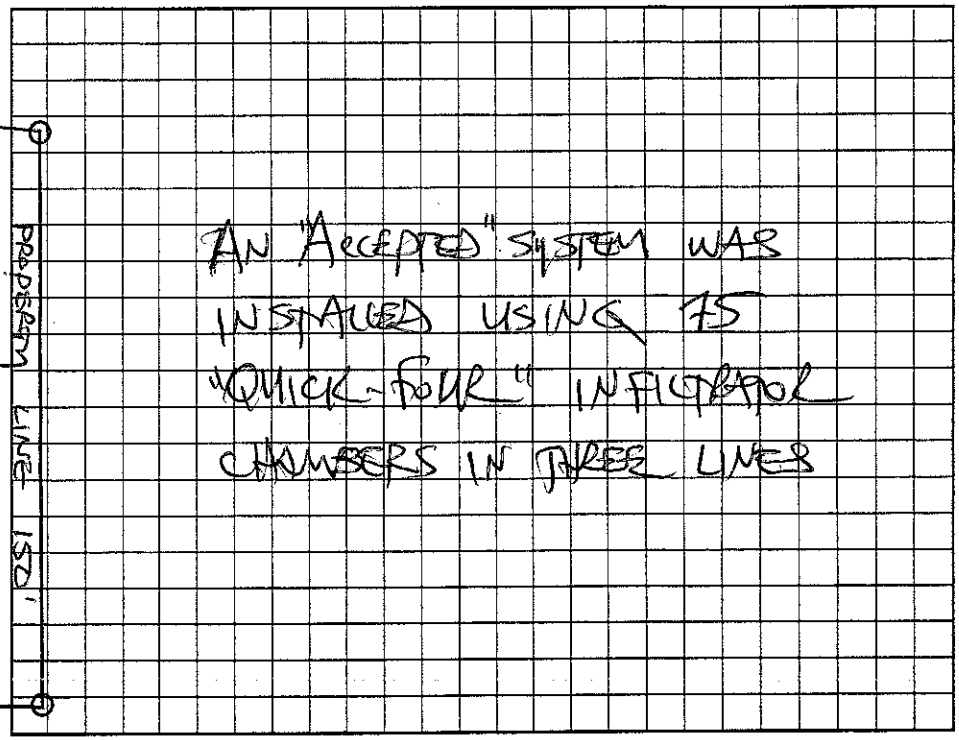

SCALE: 1" = 50'

Permit can be suspended or revoked if any false information is supplied toward securing the permit/any unauthorized changes are made to the site/any unauthorized changes are made in the installation of the system. Improvement Permit with plat valid without expiration. Improvement Permit with site plan valid for sixty months. Authorization to Construct is valid for a period equal to that of Improvement Permit – not to exceed sixty months.

Signed: Cynthia J Rogers date 9-8-04

Improvement Permit by: STEVE HEDRICK date 9-8-04

Authorization to Construct by: STEVE HEDRICK date 9-8-04

Installed by: TOMMY RYE

Operation Permit by: STEVE HEDRICK date 10-3-05

Existing System Inspection by: ____ date ____

HEALTH DEPT. COPY: WHITE OWNER COPY (FINAL): YELLOW OWNER COPY (INITIAL): PINK