IREDELL COUNTY HEALTH DEPARTMENT

THIS PERMIT VOIDS PREVIOUS ISSUED 8-26-03

STATESVILLE 704-878-5305 (C1) MOORESVILLE 704-664-5281

IMPROVEMENT PERMIT / AUTHORIZATION TO CONSTRUCT / OPERATION PERMIT / EXISTING SYSTEM INSPECTION

PERMIT# 115166 PIN# 4756-67-7566 DATE 11-25-03

OWNER OR CONTRACTOR HORNE BUILDING, INC PHONE: Business 704-902-0399 Home 704-878-2224

ADDRESS 254 FARMWOOD DRIVE, STATESVILLE, NC 28625

LOCATION US 21 NORTH, TR JANE SOWERS ROAD, TL STONEHOUSE DRIVE, HOUSE ON LEFT AT CRABAPPLE LANE

SUBDIVISION BALMONT MEADOWS BLOCK / SECTION ____ LOT 124 LOT AREA LIMITED SITE CLASS. PS DESIGN FLOW 360 L.T.A.R. 0.25 GPD/FT²

Septic Tank: 1000 Gallons; STB 794 Date 3-22-04

Pump Tank: ____ Gallons; PT ____ Date ____

Pump Make: ____ Model ____ Serial No. ____

Nitrification Field: No Fields 1 Square Feet EQ. TO 1440 Linear Feet 360

No Lines THREE Trench Width 36" Max Trench Bottom Depth 36" Gravel Depth N/A

☑ New System ☐ Repair System Type: I, II, (III), IV, V, VI

System Description: 25% REDUCTION, GRAVITY

Repair System Description: 25% REDUCTION, PUMP

Maintenance Agreement Required: ☐ Yes ☑ No

☑ House/Mod. Home No. Bedrooms 3

☐ Mobile Home No. Bathrooms 3

☐ Business No. Employees ____

☐ Other ____


☑ Slab ☐ Crawl Space ☐ Basement w/plumbing ☐ Basement wo/plumbing

Water Supply: ☐ Individual ☑ Public ☐ Community

Comments/Conditions: INSTALL 25% REDUCTION SYSTEM ON CONTOUR AS SHOWN. KEEP SYSTEM MINIMUM 10 FEET FROM WATER LINE.

Comments/Conditions: SEPTIC TANK WITH MARKER INSTALLED USING "POLYLOK" (RED) FILTER

INITIAL SITE SKETCH

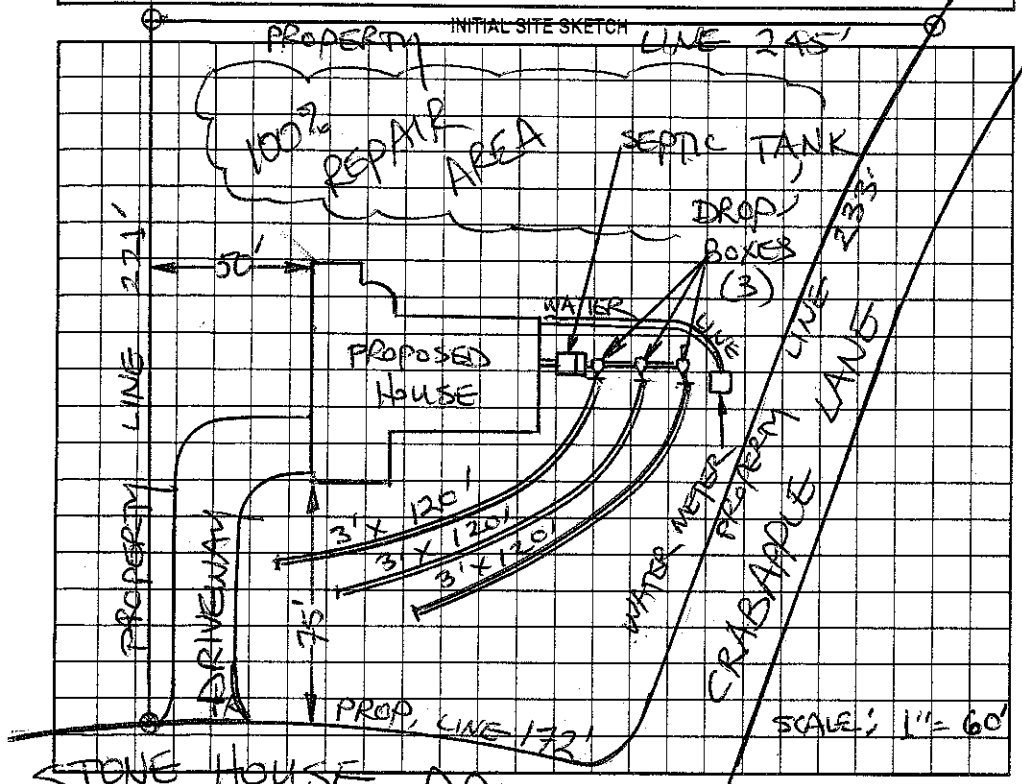

AS BUILT SKETCH

SYSTEM INSTALLED USING NINETY (90) "QUICK-4" INFILTRATOR CHAMBERS WITH 25% REDUCTION WARRANTY

Permit can be suspended or revoked if any false information is supplied toward securing the permit/any unauthorized changes are made to the site/any unauthorized changes are made in the installation of the system. Improvement Permit with plat valid without expiration. Improvement Permit with site plan valid for sixty months. Authorization to Construct is valid for a period equal to that of Improvement Permit – not to exceed sixty months.

Signed: Jeffrey Horne date 11-26-03

Improvement Permit by: STEVE HEDRICK date 11-25-03

Authorization to Construct by: STEVE HEDRICK date 11-25-03

Installed by: TUCKER'S HAULING & GRADING

Operation Permit by: STEVE HEDRICK date 6-1-04

Existing System Inspection by: ____ date ____

HEALTH DEPT. COPY: WHITE OWNER COPY (FINAL): YELLOW OWNER COPY (INITIAL): PINK