IREDELL COUNTY HEALTH DEPARTMENT

CA

STATESVILLE 704-878-5305 MOORESVILLE 704-664-5281

IMPROVEMENT PERMIT / AUTHORIZATION TO CONSTRUCT / OPERATION PERMIT / EXISTING SYSTEM INSPECTION

PERMIT# 48055 PIN# 4756697874 802 DATE 2-27-08

OWNER OR APPLICANT Mayhaw Wind Builders LLC PHONE: Business 704-902-3907 Home

ADDRESS Box 54 Catawba, NC 28609

LOCATION 2W (R) Gen. Sowers (L) Beaumont or Stone Ridge (L) Crab Apple

SUBDIVISION Beaumont BLOCK / SECTION LOT 2 LOT AREA 1.13 SITE CLASS. 15 DESIGN FLOW 480 L.T.A.R. .3

Septic Tank: 1000 Gallons; STB 1012 Date

Pump Tank: Gallons; PT Date

Pump Make: Model Serial No.

Nitrification Field: No Fields 1 Square Feet 1600 Linear Feet 480

No Lines 4 Trench Width 36" Max Trench Bottom Depth 36 Gravel Depth 12

☑ New System ☐ Repair ☐ Expansion System Type: I II III IV V VI

System Description: 25% Ground

Repair System Description: 25% Ground

Maintenance Agreement Required: ☐ Yes ☑ No

☐ House/Mod. Home ☐ Mobile Home ☐ Business ☐ Other

No. Bedrooms 4 No. Persons No. Employees


Water Supply: ☐ Individual ☑ Public ☐ Community

☐ Gravity ☑ Pressure ☐ Slab ☑ Crawl Space ☐ Basement w/plumbing ☐ Basement wo/plumbing


Comments:/Conditions: NOT to SCALE Address: 25 Crabapple

Comments:/Conditions: Do not disturb or contour Maintain all setbacks

INITIAL SITE SKETCH

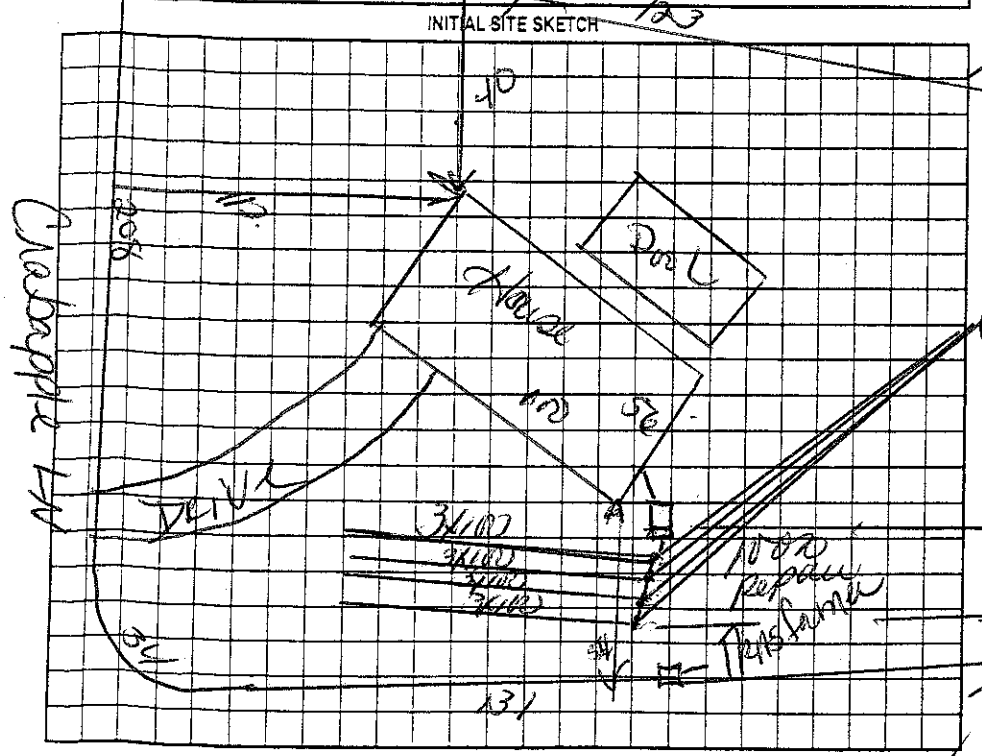

AS BUILT SKETCH

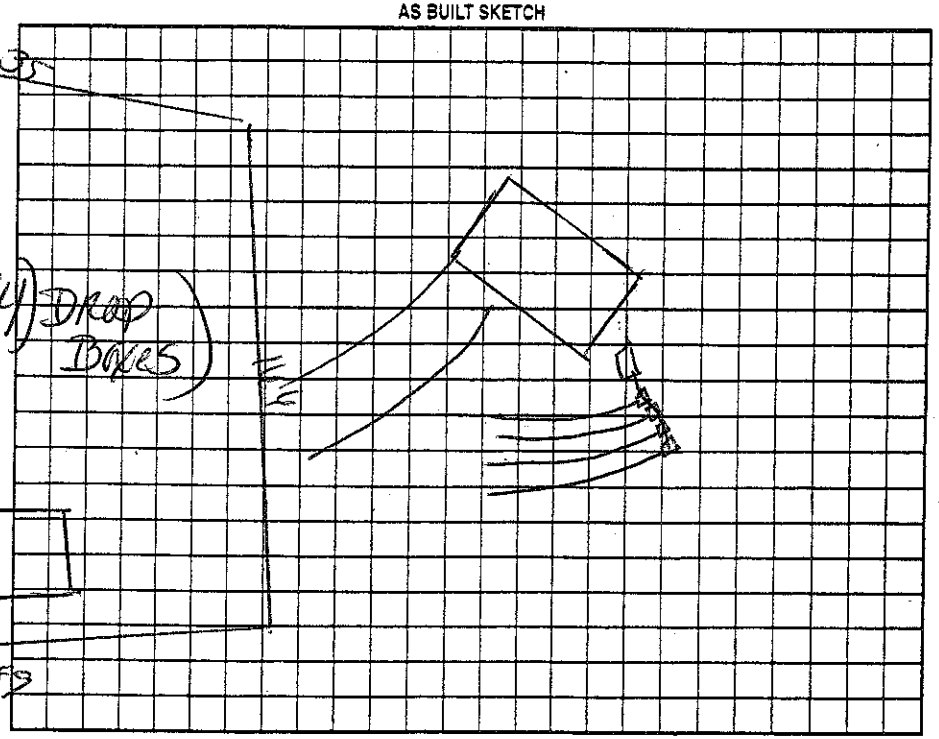

Permit can be suspended or revoked if any false information is supplied toward securing the permit/any unauthorized changes are made to the site/any unauthorized changes are made in the installation of the system. Improvement Permit with plat valid without expiration ☐ Improvement Permit with site plan valid for sixty months ☑ Authorization to Construct is valid for a period equal to that of Improvement Permit – not to exceed sixty months.

Signed: date

Improvement Permit by: Kelly Cox date 2-28-08

Authorization to Construct by: Kelly Cox date 2-28-08

Installed by: Tommy Fryc

Operation Permit by: date 8-14-08

Existing System Inspection by: date

HEALTH DEPT. COPY: WHITE OWNER COPY (FINAL): YELLOW OWNER COPY (INITIAL): PINK