IREDELL COUNTY HEALTH DEPARTMENT

STATESVILLE 704-878-5305 MOORESVILLE 704-664-5281

IMPROVEMENT PERMIT / AUTHORIZATION TO CONSTRUCT / OPERATION PERMIT / EXISTING SYSTEM INSPECTION

PERMIT# 123884 PIN# 4756681355

OWNER OR APPLICANT America's Home Place PHONE: Business 704-664-5800 Home

DATE 7-10-08

ADDRESS 168-D Norman Station Boulevard

LOCATION 21N to Jane Sowers Rd to Baymount Drive Straight Morning View Lane

SUBDIVISION Baymount, Stone Haven BLOCK / SECTION LOT 43 LOT AREA .96 Ac SITE CLASS. PS DESIGN FLOW 480 L.T.A.R. .3

Septic Tank: 1000 Gallons; STB 1007 Date 7-4-08

Pump Tank: Gallons; PT Date

Pump Make: Model Serial No.

Nitrification Field: No Fields Square Feet 1600 Linear Feet 400

No. Lines 6 Trench Width 36" Max Trench Bottom Depth 36" Gravel Depth N/A

☑ New System ☐ Repair ☐ Expansion System Type: I II III IV V VI

System Description: 2.5" to Gravity

Repair System Description: 50% to LPD

Maintenance Agreement Required: ☐ Yes ☑ No

☑ Gravity ☐ Pressure

☑ House/Mod. Home ☐ Mobile Home ☐ Business ☑ Other

No. Bedrooms 4 No. Persons No. Employees

Water Supply: ☐ Individual ☑ Public ☐ Community


☐ Slab ☑ Crawl Space ☐ Basement w/plumbing ☐ Basement wo/plumbing

Comments:/Conditions:


Comments:/Conditions:

Install on contour
Maintain all setbacks
brown nsf filter in tank

INITIAL SITE SKETCH

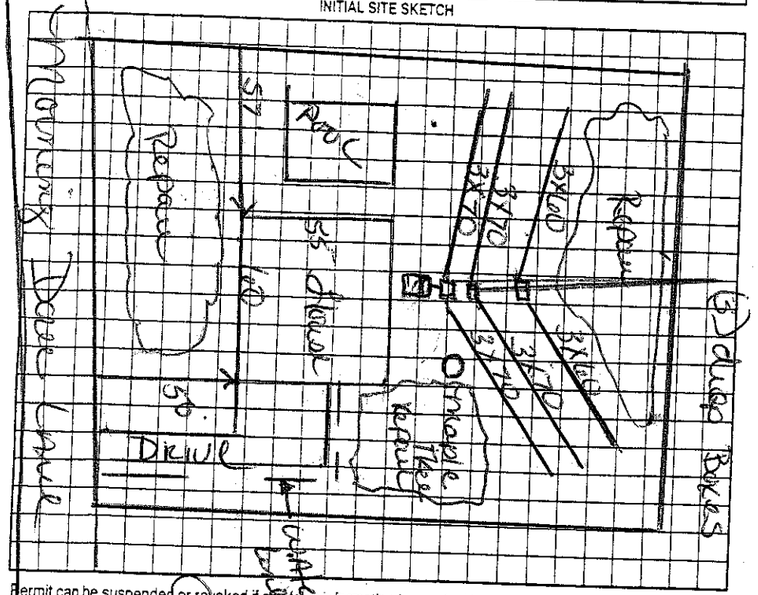

AS BUILT SKETCH

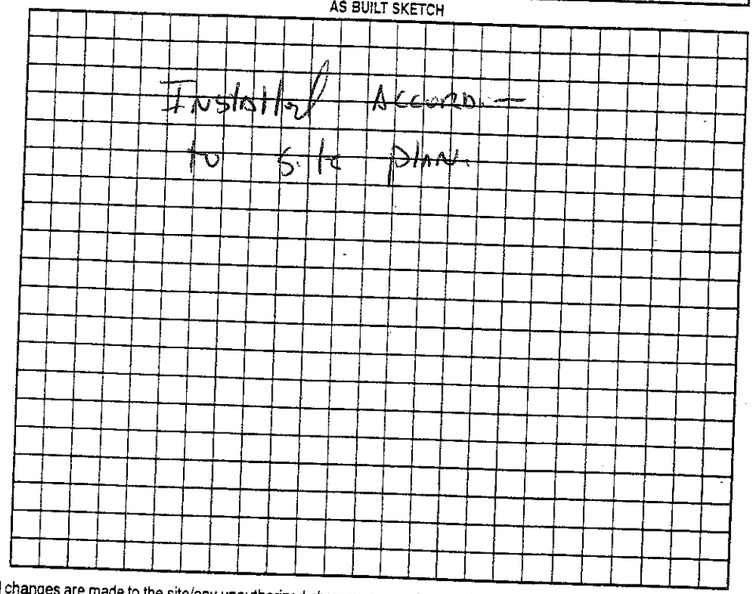

Permit can be suspended or revoked if any false information is supplied toward securing the permit/any unauthorized changes are made to the site/any unauthorized changes are made in the installation of the system. Improvement Permit with plan valid without expiration ☐ Improvement Permit with site plan valid for sixty months ☑ Authorization to Construct is valid for a period equal to that of Improvement Permit – not to exceed sixty months.

Signed: date 7-10-08

Improvement Permit by: Kelly Cook date 7-10-08

Authorization to Construct by: Kelly Cook date 7-10-08

Installed by: Kevin Bowles

Operation Permit by: R.S. date 30 Oct 08

Existing System Inspection by: date

HEALTH DEPT. COPY: WHITE OWNER COPY (FINAL): YELLOW OWNER COPY (INITIAL): PINK