Porter OP - 9/21 WF

IREDELL COUNTY HEALTH DEPARTMENT

STATESVILLE 704-878-5305 MOORESVILLE 704-664-5281

IMPROVEMENT PERMIT / AUTHORIZATION TO CONSTRUCT / OPERATION PERMIT / EXISTING SYSTEM INSPECTION

PERMIT# 93670 PIN# 4756 68 3872 DATE 1/18/01

OWNER OR CONTRACTOR The Finish Touch PHONE: Business 872-0573 Home

ADDRESS 712 N Center St Statesville NC 28677

LOCATION 21N, R Jane Sowers, L Baymount, Straight Morning Dove on Rt

SUBDIVISION Baymount BLOCK / SECTION LOT 130 LOT AREA 0.84 AC SITE CLASS PS DESIGN FLOW 360 L.T.A.R. 0.3

Septic Tank: 1000 Gallons: STB 794 Date 11-29-00
Pump Tank: Gallons: PT Date
Pump Make: Model Serial No.
Nitrification Field: No Fields 1 Square Feet 630 Linear Feet 210
No Lines 6 @ 35' Trench Width 36" Max Trench Bottom Depth 36"


☒ New System ☐ Repair System Type: I, II, III, IV, V, VI
System Description: Gravity PPBS
Repair System Description: Pickup PPBS
Maintenance Agreement Required: ☐ Yes ☒ No
Gravel Depth —

☒ House/Mod. Home No. Bedrooms 3
☐ Mobile Home No. Bathrooms 3½
☐ Business No. Employees
☐ Other
☐ Slab ☒ Crawl Space ☐ Basement w/plumbing ☐ Basement wo/plumbing

Water Supply: ☐ Individual ☒ Public ☐ Community


Comments/Conditions: System fed with one flow divider and 2 distribution Boxes - All supply lines going under the drive Need to be sleeved in ductile iron or equivalent

INITIAL SITE SKETCH Not to Scale

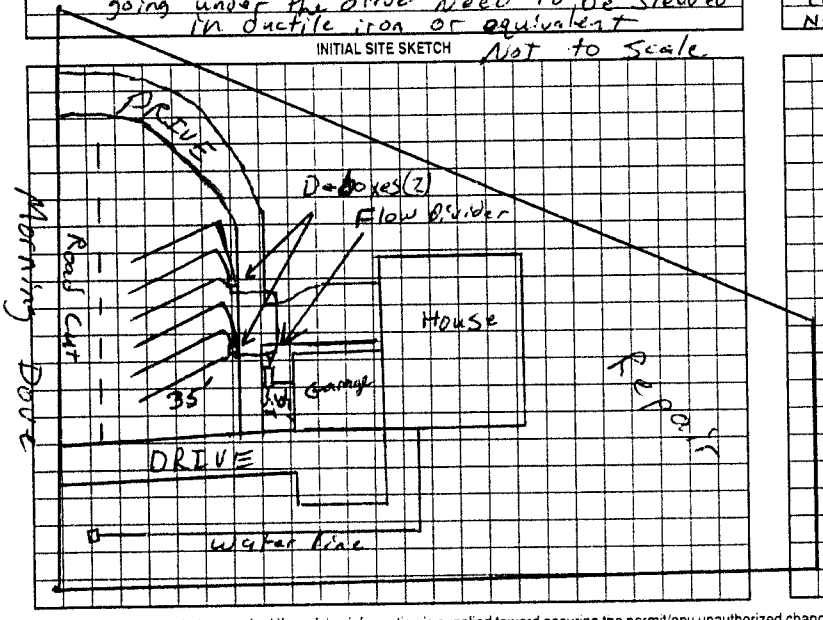

Comments/Conditions: ZABEL FILTER
CHECKED FIRST LINE
CHECKED LINES 2-5 & SAND
NEEDS LAST LINE CHECKED AND SPEED LEVELERS SET

AS BUILT SKETCH Okay wf

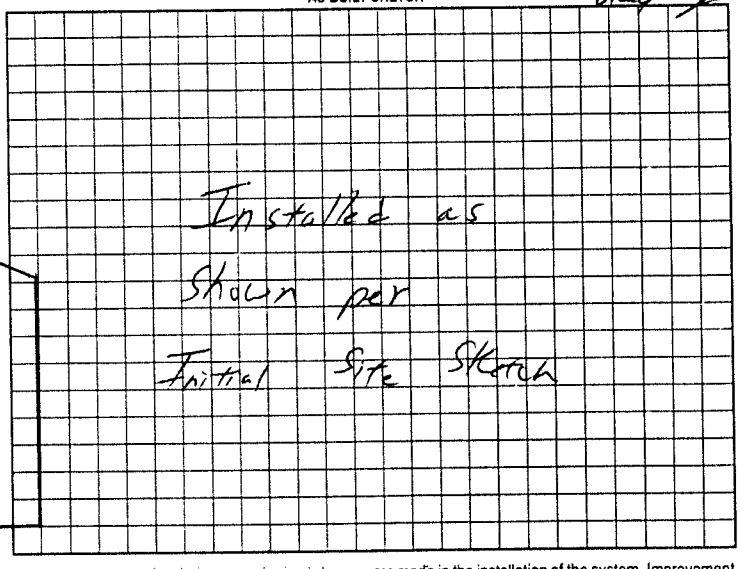

Permit can be suspended or revoked if any false information is supplied toward securing the permit/any unauthorized changes are made to the site/any unauthorized changes are made in the installation of the system. Improvement Permit with plat valid without expiration. Improvement Permit with site plan valid for sixty months. Authorization to Construct is valid for a period equal to that of Improvement Permit - not to exceed sixty months.

Signed: Wanda Sutton date 1-19-01 Installed by: Wes Lytton

Improvement Permit by: M Mey RST date 1/18/01 Operation Permit by: William O. Johnson date 9/21/01

Authorization to Construct by: M Mey RST date 1/18/01 Existing System Inspection by: date

HEALTH DEPT. COPY: WHITE OWNER COPY (FINAL): YELLOW OWNER COPY (INITIAL): PINK