IREDELL COUNTY HEALTH DEPARTMENT

STATESVILLE 704-878-5305 (2) MOORESVILLE 704-664-5281

IMPROVEMENT PERMIT / AUTHORIZATION TO CONSTRUCT / OPERATION PERMIT / EXISTING SYSTEM INSPECTION

PERMIT# 110299 PIN# 4756-68-4429 DATE 12-30-02

OWNER OR CONTRACTOR JOSEPH KEENAN PHONE: Business 704-624-2069 Home 704-528-1987

ADDRESS 305 WAGNER ST. [redacted] TROUTMAN, NC 28166

LOCATION HWY 21 N, (1) JANE SOWERS, (2) BAYMOUNT DR, STRAIGHT ACROSS AT X ROADS ON MORNING DOVE COURT, (3) LOT # 128

SUBDIVISION BAYMOUNT STONE HOMES SECTION ____ LOT 128 LOT AREA .96 AC SITE CLASS PS DESIGN FLOW 480 L.T.A.R. .3

Septic Tank: 1000 Gallons; STB 1012 Date 9-24-03
Pump Tank: ____ Gallons; PT ____ Date ____
Pump Make: ____ Model ____ Serial No. 533'
Nitrification Field: No Fields 1 Square Feet 1600' Linear Feet [redacted]
No Lines [redacted] 8 Trench Width 36" Max Trench Bottom Depth 36" Gravel Depth 12"


[X] New System [ ] Repair System Type: I, [II], III, IV, V, VI
System Description: CONV GRAV
Repair System Description: GRAV / PUMP CONV
Maintenance Agreement Required: [ ] Yes [X] No

[X] House/Mod. Home No. Bedrooms 4
[ ] Mobile Home No. Bathrooms 3 1/2
[ ] Business No. Employees ____
[ ] Other ____
[ ] Slab [X] Crawl Space [ ] Basement w/plumbing [ ] Basement wo/plumbing

Water Supply: [ ] Individual [X] Public [ ] Community

Comments/Conditions: (1) MAINTAIN SETBACKS (2) HOUSE HAS SLID BACK 20' FROM ORIGINAL STAKES ON LOT. DRAWING BELOW IS ACCURATE. (3) KEEP LINES 15' OFF TOP OF EMBANKMENT CUT. (4) HOUSE & LINES ARE "NOT TO SCALE"

INITIAL SITE SKETCH

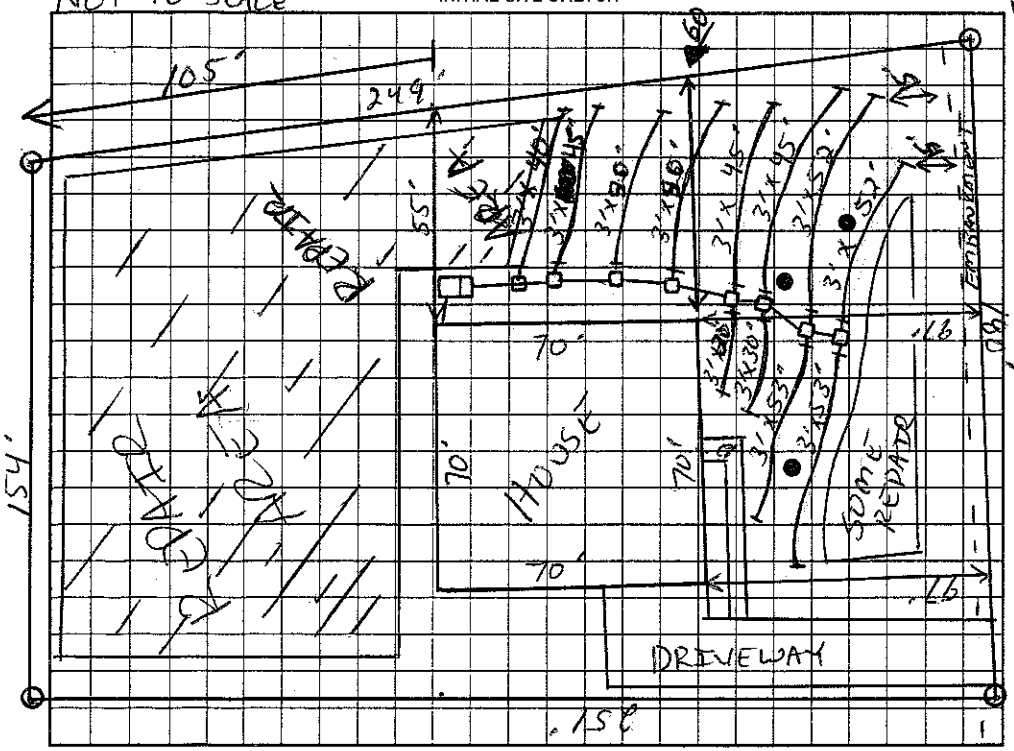

Comments/Conditions: COMPLETELY SHOT IN. (5) BLACK DOT'S BETWEEN LINES ARE TREE'S (6) LINE #1 IS NOT FLAGGED. CALL PRIOR TO INSTALLATION TO BE FLAGGED IF NEEDED (7) KEEP H2O LINE 10' FROM ANY PART OF THE SYSTEM.

AS BUILT SKETCH

(X) 8 LINES
1ST LINE = 40'
2nd LINE = ~~45~~ 40'
3rd LINE = ~~50~~ 48'
4th LINE = ~~50~~ 65'
5th LINE = ~~65~~ 70'
6th LINE = ~~75~~ 80'
7th LINE = ~~105~~ 90'
8th LINE = 105'
TOTAL = ~~535~~ 538'

(1) SEPTIC TANK WITH MARKER INSTALLED USING "TUFTITE" FILTER
(3) SYSTEM INSTALLED ACCORDING TO INITAL SITE SKETCH

Permit can be suspended or revoked if any false information is supplied toward securing the permit/any unauthorized changes are made to the site/any unauthorized changes are made in the installation of the system. Improvement Permit with plat valid without expiration. Improvement Permit with site plan valid for sixty months. Authorization to Construct is valid for a period equal to that of Improvement Permit – not to exceed sixty months.

Signed: [signature] date 1/8/03
Improvement Permit by: [signature] RS date 12-30-02
Authorization to Construct by: [signature] RS date 12-30-02

Installed by: PIEDMONT BACKHOE
Operation Permit by: STEVE HEDRICK date 3-26-04
Existing System Inspection by: ____ date ____

HEALTH DEPT. COPY: WHITE OWNER COPY (FINAL): YELLOW OWNER COPY (INITIAL): PINK