IREDELL COUNTY HEALTH DEPARTMENT

STATESVILLE 704-878-5305 (C1) MOORESVILLE 704-664-5281

IMPROVEMENT PERMIT / AUTHORIZATION TO CONSTRUCT / OPERATION PERMIT / EXISTING SYSTEM INSPECTION

PERMIT# 122418 PIN# 4756-68-6107 DATE 7-20-04

OWNER OR CONTRACTOR DANNY M. LIPPARD CONST. LLC PHONE: Business 704-902-4918 Home 704-871-1800

ADDRESS P.O. BOX 629, STATESVILLE, NC 28677

LOCATION US 21 N TR JANE SOWERS ROAD, TL BAYMOUNT DR CONTINUE MORNING DOVE LANE 2ND LOT ON RIGHT

SUBDIVISION BAYMOUNT MEADOWS BLOCK / SECTION ____ LOT 149 LOT AREA 2.21 ACRES SITE CLASS. PS DESIGN FLOW 480 L.T.A.R. 0.30 GPD/FT²

Septic Tank: 1000 Gallons; STB 1012 Date 4-11-05

Pump Tank: 1000 Gallons; PT 17 Date 6-27-05

Pump Make: GOULDS Model WE0512H Serial No. E055446

Nitrification Field: No Fields 1 Square Feet 1600 Linear Feet 533'

No Lines FOUR Trench Width 36" Max Trench Bottom Depth 36" Gravel Depth 12"

☑ New System ☐ Repair System Type: I, II, III, IV, PUMP

System Description: CONVENTIONAL

Repair System Description: 25% REDUCTION, PUMP

Maintenance Agreement Required: ☐ Yes ☑ No

☑ House/Mod. Home No. Bedrooms 4

☐ Mobile Home No. Bathrooms ____

☐ Business No. Employees ____

☐ Other ____

☐ Slab ☐ Crawl Space ☑ Basement w/plumbing ☐ Basement wo/plumbing


Water Supply: ☐ Individual ☑ Public ☐ Community

Comments./Conditions: PROPERTY LINE 377'

EXISTING BARN

PRESSURE MANIFOLD

INITIAL SITE SKETCH

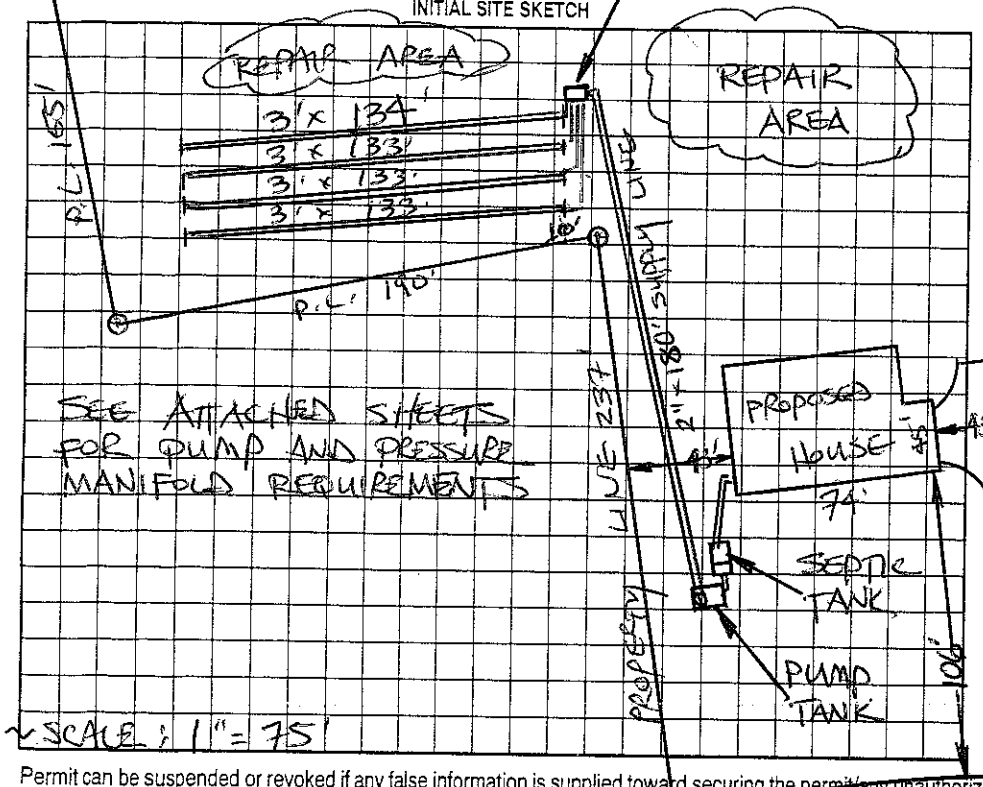

SEE ATTACHED SHEETS FOR PUMP AND PRESSURE MANIFOLD REQUIREMENTS

SCALE: 1" = 75'

Comments./Conditions: SEPTIC TANK WITH RISERS INSTALLED USING "TUFTITE" FILTER

AS BUILT SKETCH

AN "ACCEPTED" SYSTEM WAS INSTALLED USING "QUICK-4" INFILTRATOR CHAMBERS (100)

Permit can be suspended or revoked if any false information is supplied toward securing the permit/any unauthorized changes are made to the site/any unauthorized changes are made in the installation of the system. Improvement Permit with plat valid without expiration. Improvement Permit with site plan valid for sixty months. Authorization to Construct is valid for a period equal to that of Improvement Permit – not to exceed sixty months.

Signed: David K. Young date 7-20-04 Installed by: DAVID YOUNG

Improvement Permit by: STEVE HEDRICK date 7-20-04 Operation Permit by: STEVE HEDRICK date 10-10-05

Authorization to Construct by: STEVE HEDRICK date 7-20-04 Existing System Inspection by: ____ date ____

MORNING DOVE LANE (SR 2264)

HEALTH DEPT. COPY: WHITE OWNER COPY (FINAL): YELLOW OWNER COPY (INITIAL): PINK