IREDELL COUNTY HEALTH DEPARTMENT

STATESVILLE 704-878-5305 MOORESVILLE 704-664-5281

IMPROVEMENT PERMIT / AUTHORIZATION TO CONSTRUCT / OPERATION PERMIT / EXISTING SYSTEM INSPECTION

PERMIT# 44461 PIN# 4756469 1916

OWNER OR APPLICANT Jom Palmer Homes Inc DATE 9-27-07

ADDRESS Box 2387 Davidson NC 28036 PHONE: Business 704 500-2104 Home

LOCATION Hwy 21 Jane Sowers to Baymont lot on Right

SUBDIVISION Baymont BLOCK / SECTION LOT LOT AREA .977 SITE CLASS. PS DESIGN FLOW 480 L.T.A.R. .3

Septic Tank: 1000 Gallons: STB 512 Date 1-2-08

Pump Tank: Gallons: PT Date

Pump Make: Model Serial No.

Nitrification Field: No Fields Square Feet 1600 Linear Feet 400

No Lines 4 Trench Width 36" Max Trench Bottom Depth 36" Gravel Depth

☒ New System ☐ Repair ☐ Expansion System Type: I [II] III IV V VI

System Description: 25% Gravel

Repair System Description: 50% low Pres.

Maintenance Agreement Required: ☐ Yes ☒ No

☒ Gravity ☐ Pressure

☒ House/Mod. Home ☐ Mobile Home ☐ Business ☐ Other

No. Bedrooms 4 No. Persons No. Employees


Water Supply: ☐ Individual ☒ Public ☐ Community

☐ Slab ☒ Crawl Space ☐ Basement w/plumbing ☐ Basement wo/plumbing

Comments:/Conditions:

Comments:/Conditions: Maintain all setbacks Install on Contour

INITIAL SITE SKETCH

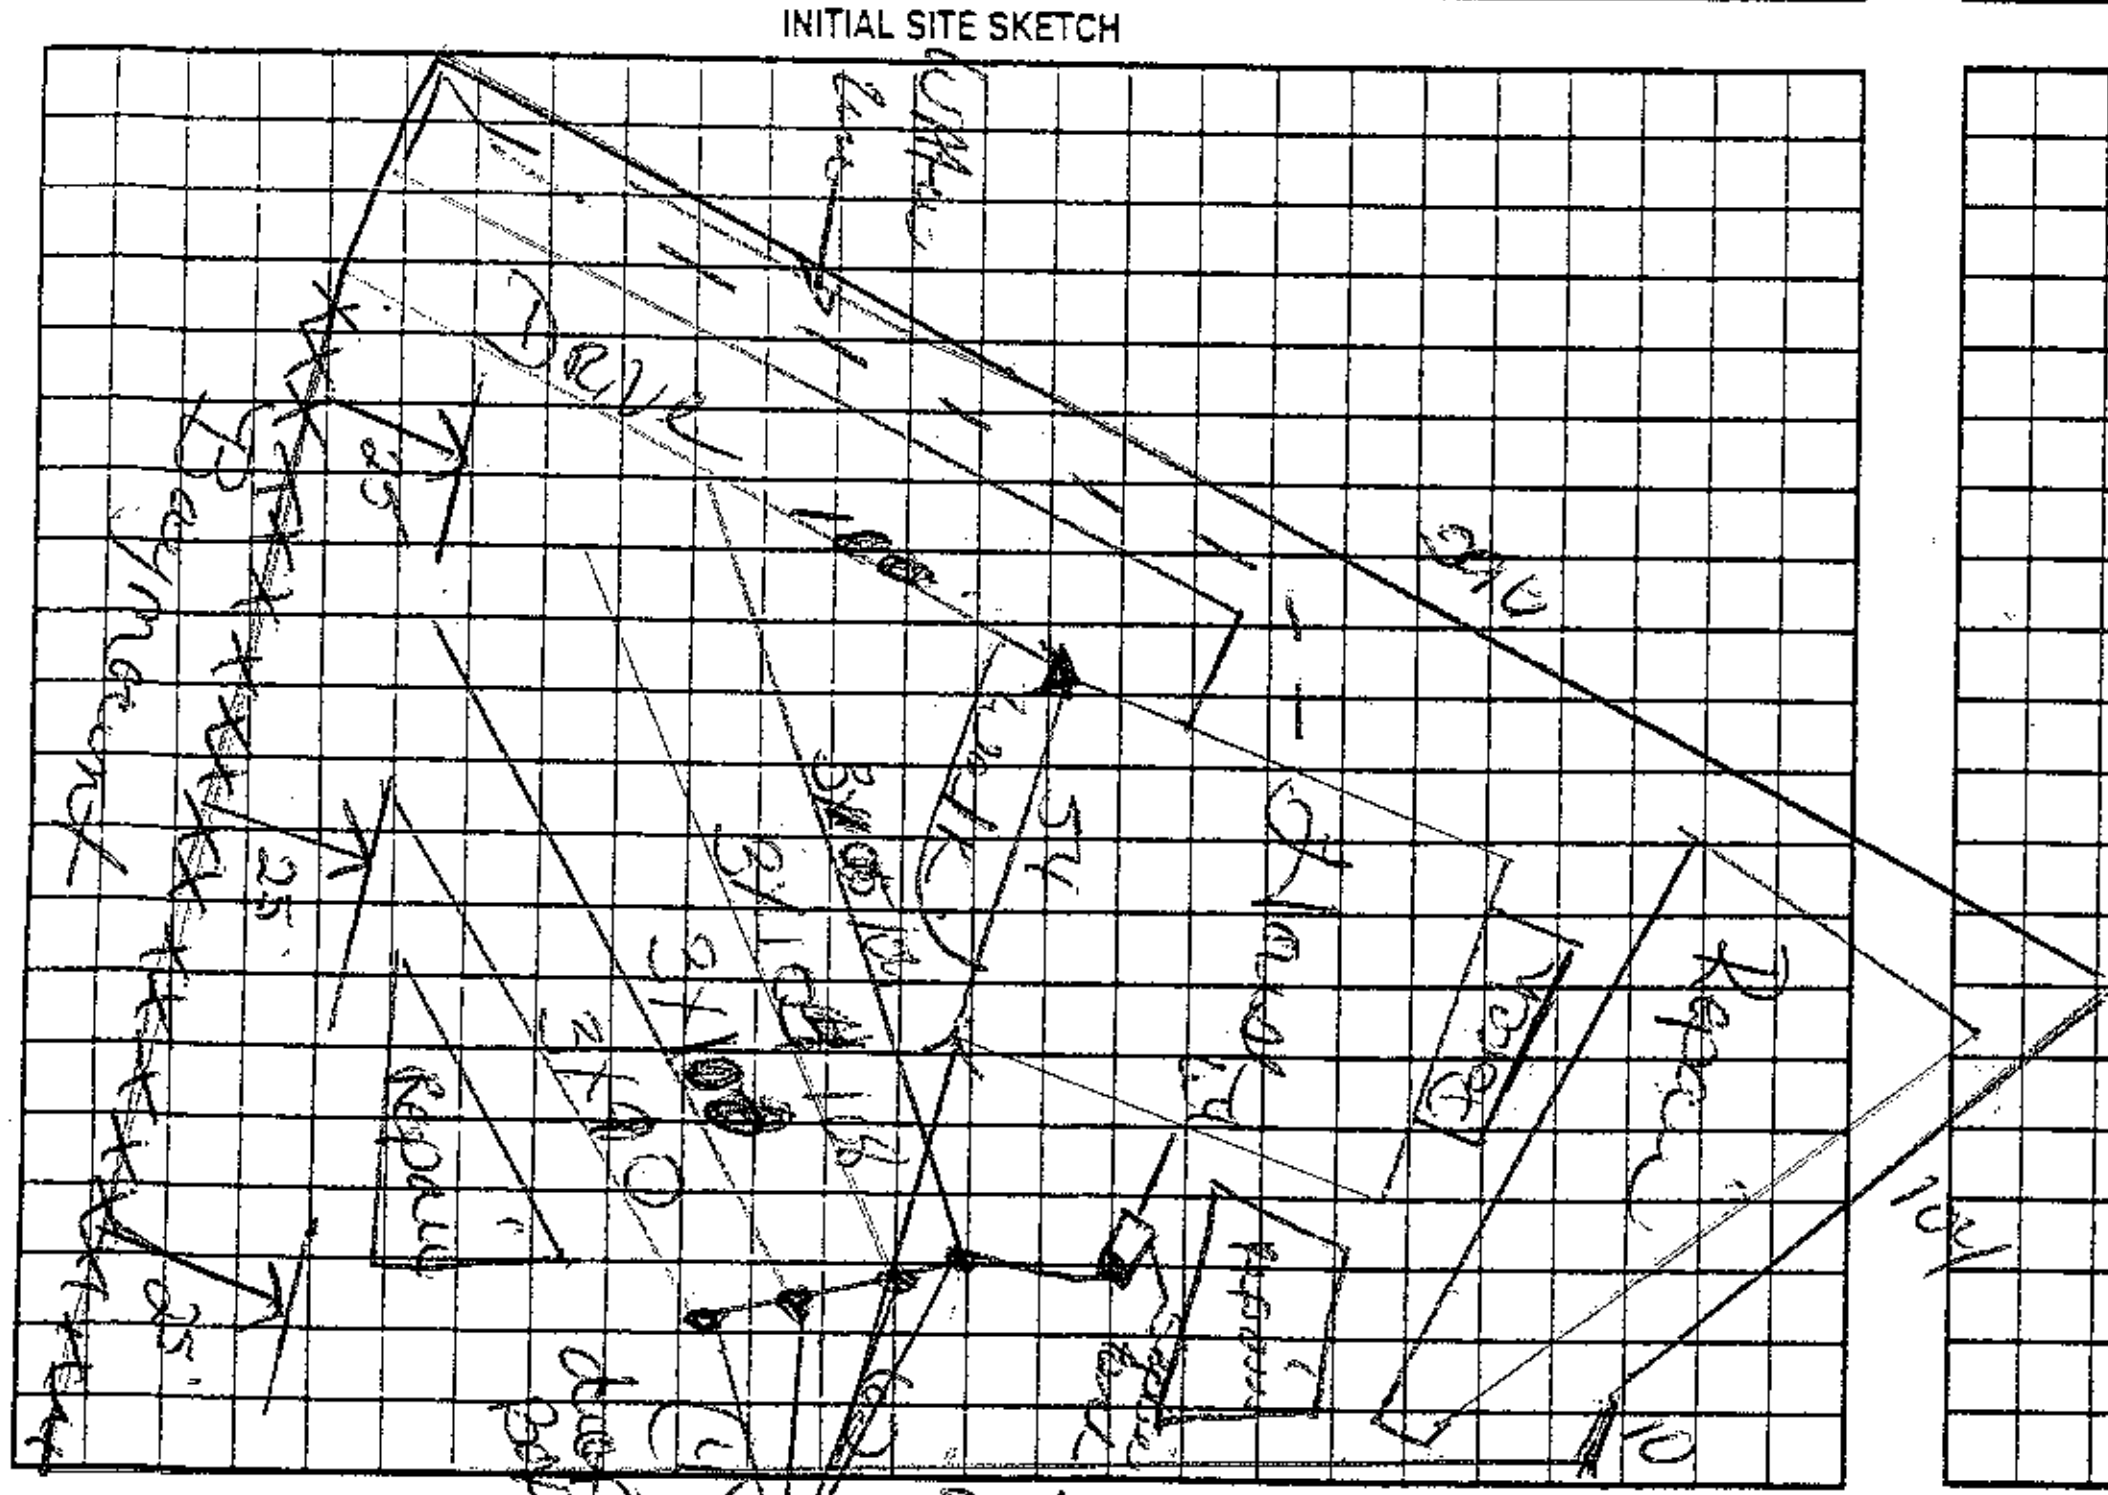

AS BUILT SKETCH

Oney Poly Septic Marker

Permit can be suspended or revoked if any false information is supplied toward securing the permit/any unauthorized changes are made to the site/any unauthorized changes are made in the installation of the system. Improvement Permit with plat valid without expiration ☐ Improvement Permit with site plan valid for sixty months ☒ Authorization to Construct is valid for a period equal to that of Improvement Permit – not to exceed sixty months.

Signed: [signature] date

Improvement Permit by: Kelly Cook date 9-27-07

Authorization to Construct by: Kelly Cook date 9-27-07

Installed by: Lenard McSwain

Operation Permit by: Kelly J Cook date 3/13/2008

Existing System Inspection by: date

HEALTH DEPT. COPY: WHITE OWNER COPY (FINAL): YELLOW OWNER COPY (INITIAL): PINK