IREDELL COUNTY HEALTH DEPARTMENT

STATESVILLE 704-878-5305 MOORESVILLE 704-664-5281

IMPROVEMENT PERMIT / CERTIFICATE OF COMPLETION / OPERATION PERMIT / EXISTING SYSTEM INSPECTION

PROPERTY DESCRIPTION NO. 19304 DATE 9-1-94 TAX MAP NO. 11E-A-109 A Watershed: ☐ Yes ☑ No

OWNER OR CONTRACTOR Jerry C. Gregory PHONE: Business Home 871 1611

ADDRESS 351 old mocksville Rd Statesville, N.C.

LOCATION NE Tb old mocksville Rd 1mi Tb Private St 2nt lot on left

SUBDIVISION BLOCK / SECTION LOT LOT AREA .56acres SITE CLASS. PS DESIGN FLOW 240 L.T.A.R.

Septic Tank: Gallons; STB Date

Pump Tank: Gallons; PT Date

Pump Make: Model Serial No.

Nitrification Field: No Fields 1 Square Feet 750 Linear Feet 250

No Lines 2 Trench Width 36" Max Trench Bottom Depth 36" Gravel Depth 10"

☐ New System ☐ Repair System Type: I, II, III, IV, V, VI

System Description:

Repair System Description:

Maintenance Agreement Required: ☐ Yes ☐ No

☐ House/Mod. Home ☑ Mobile Home ☐ Business ☐ Other

No. Bedrooms 2 No. Bathrooms 2 No. Employees

☐ Slab ☐ Crawl Space ☐ Basement w/plumbing ☐ Basement wo/plumbing


Water Supply: ☑ Individual ☐ Community ☐ Public well Next to it

Comments:

Comments: Keep Home 5' from any Part of ST. System

INITIAL SITE SKETCH

AS BUILT SKETCH

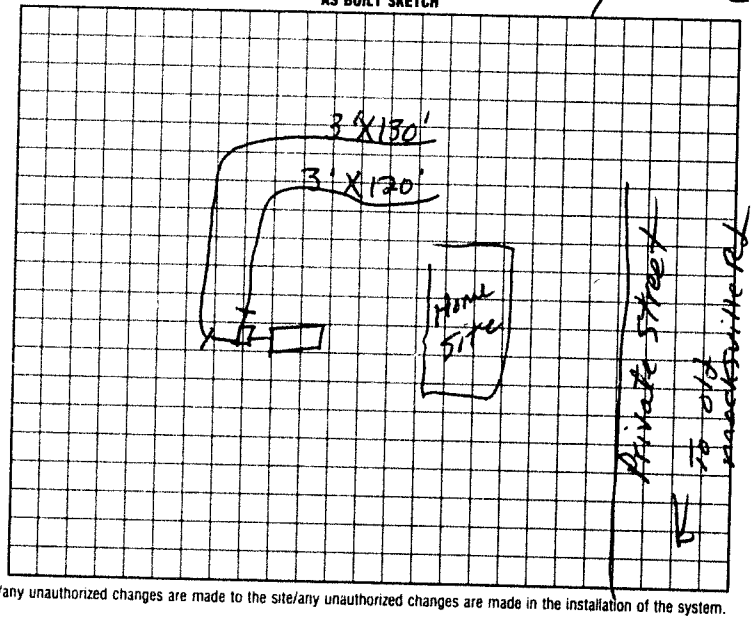

I understand that this permit can be suspended or revoked if any false information is supplied toward securing the permit/any unauthorized changes are made to the site/any unauthorized changes are made in the installation of the system. Improvement Permit is valid for 60 months from date of issuance.

Signed:

Improvement Permit by: date

Existing System Inspection by: J.C. Moore date 9-1-94

Installed by: Jerry Gregory, Tamara Pearson

Certificate of Completion by: J.C. Moore date 9-12-94

Operation Permit by: date

HEALTH DEPT. COPY: WHITE INSPECTION COPY (FINAL): GREEN OWNER COPY (FINAL): YELLOW INSPECTION COPY (INITIAL): PINK OWNER COPY (INITIAL): GOLD