IREDELL COUNTY HEALTH DEPARTMENT

STATESVILLE 704-878-5305 MOORESVILLE 704-664-5281

IMPROVEMENT PERMIT / AUTHORIZATION TO CONSTRUCT / OPERATION PERMIT / EXISTING SYSTEM INSPECTION

PERMIT# 42595 PIN# 4756716930

OWNER OR APPLICANT Barry Mayo

ADDRESS 209 Beaver Dr N Statesville, NC 28677 PHONE: Business _____ Home _____ DATE 30 May 07

LOCATION Left on Old Mocksville Rd 422 Old Mocksville Rd

SUBDIVISION _____ BLOCK / SECTION _____ LOT _____ LOT AREA _____ SITE CLASS. P3 DESIGN FLOW 240 L.T.A.R. 0% Stacked

Septic Tank: ESP 1000 Gallons; STB _____ Date _____

Pump Tank: _____ Gallons; PT _____ Date _____

Pump Make: _____ Model _____ Serial No. _____

Nitrification Field: No Fields ____ Square Feet 425 Linear Feet 250

No Lines 3 Trench Width _____ Max Trench Bottom Depth _____ Gravel Depth 10"

☐ New System ☐ Repair ☐ Expansion System Type: I II III IV V VI

System Description: 0% Stacked

Repair System Description: _____

Maintenance Agreement Required: ☐ Yes ☐ No

☐ Gravity ☐ Pressure

☐ House/Mod. Home ☑ Mobile Home ☐ Business ☐ Other

No. Bedrooms 3 No. Persons ____ No. Employees ____


Water Supply: ☐ Individual ☑ Public ☐ Community

☐ Slab ☐ Crawl Space ☐ Basement w/plumbing ☐ Basement wo/plumbing


Comments:/Conditions:

Comments:/Conditions:

INITIAL SITE SKETCH

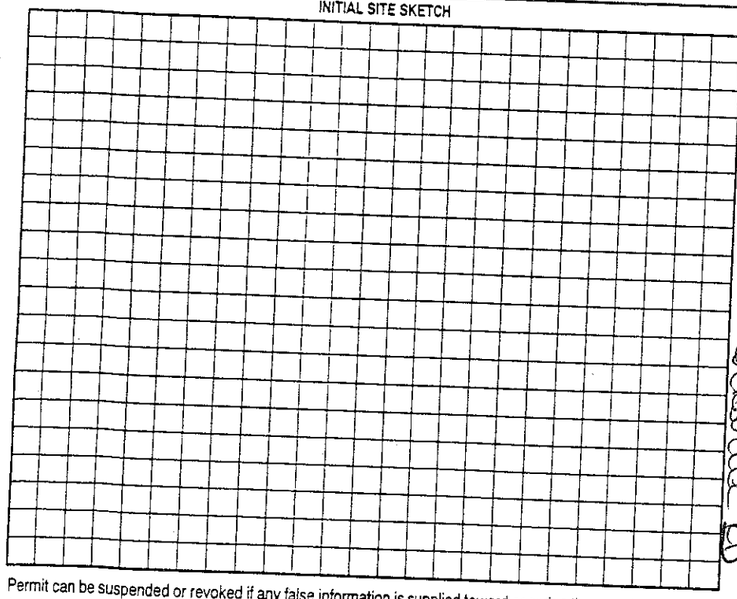

AS BUILT SKETCH

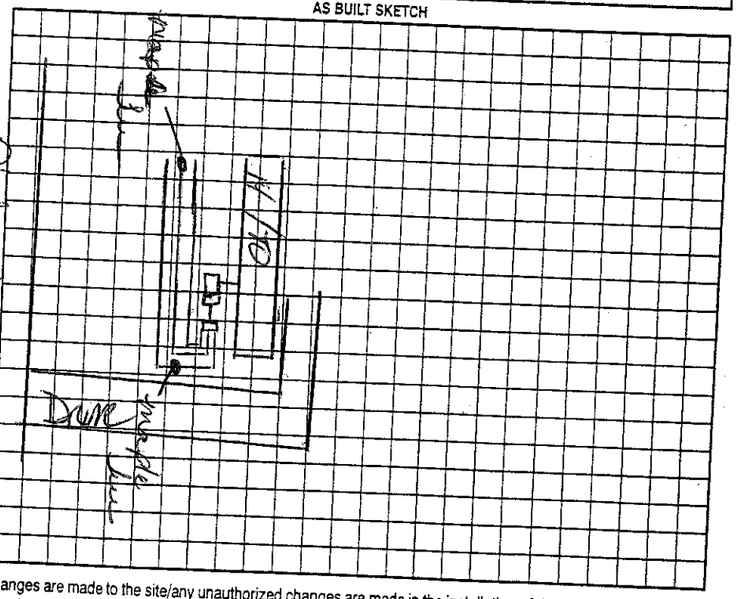

Permit can be suspended or revoked if any false information is supplied toward securing the permit/any unauthorized changes are made to the site/any unauthorized changes are made in the installation of the system. Improvement Permit with plat valid without expiration. ☐ Improvement Permit with site plan valid for sixty months ☐ Authorization to Construct is valid for a period equal to that of Improvement Permit – not to exceed sixty months.

Signed: _____ date _____ Installed by: _____

Improvement Permit by: _____ date _____ Operation Permit by: _____ date _____

Authorization to Construct by: _____ date _____ Existing System Inspection by: _____ date 31 May 07

HEALTH DEPT. COPY: WHITE OWNER COPY (FINAL): YELLOW OWNER COPY (INITIAL): PINK