IREDELL COUNTY HEALTH DEPARTMENT

STATESVILLE 704-878-5305 MOORESVILLE 704-664-5281

IMPROVEMENT PERMIT / CERTIFICATE OF COMPLETION / OPERATION PERMIT / EXISTING SYSTEM INSPECTION

PROPERTY DESCRIPTION NO. Repair DATE 10-30-97 TAX MAP NO. Repair

OWNER OR CONTRACTOR Chuck Fox PHONE: Business 928-4398 pager Home Watershed: ☐ Yes ☐ No

ADDRESS 488 Old Mocksville Rd Statesville

LOCATION 64E Old Mocksville Rd house on (R) Before Seed House Rd

SUBDIVISION BLOCK / SECTION LOT LOT AREA SITE CLASS. DESIGN FLOW L.T.A.R.

Septic Tank: 1000 Gallons; STB 1012 Date 8-15-97

Pump Tank: Gallons; PT Date

Pump Make: Model Serial No.

Nitrification Field: No Fields Square Feet Linear Feet

No Lines Trench Width Max Trench Bottom Depth Gravel Depth

☐ New System ☒ Repair System Type: I, II, III, IV, V, VI

System Description:

Repair System Description: Tank

Maintenance Agreement Required: ☐ Yes ☐ No

☒ House/Mod. Home ☐ Mobile Home ☐ Business ☐ Other

No. Bedrooms 3 No. Bathrooms 1 No. Employees


☐ Slab ☐ Crawl Space ☐ Basement w/plumbing ☐ Basement wo/plumbing

Water Supply: ☒ Individual ☐ Community ☐ Public


Comments:

Comments:

INITIAL SITE SKETCH

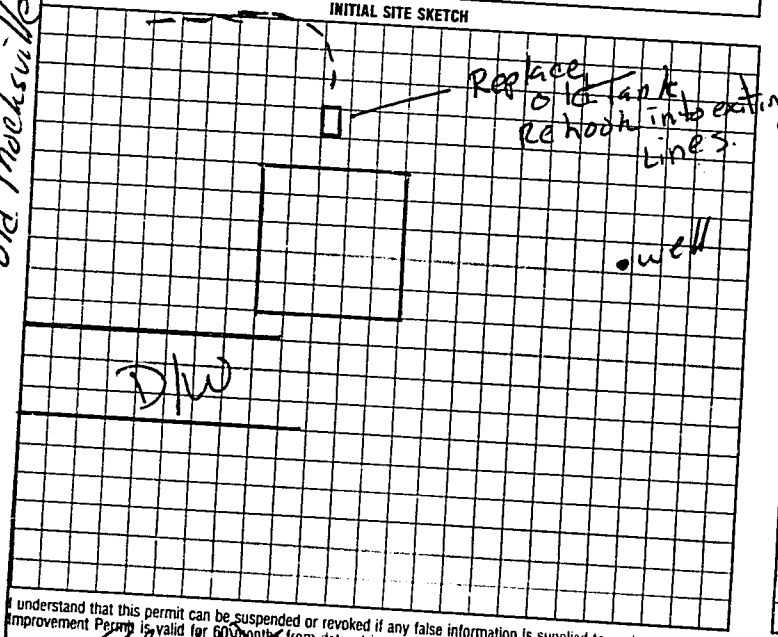

AS BUILT SKETCH

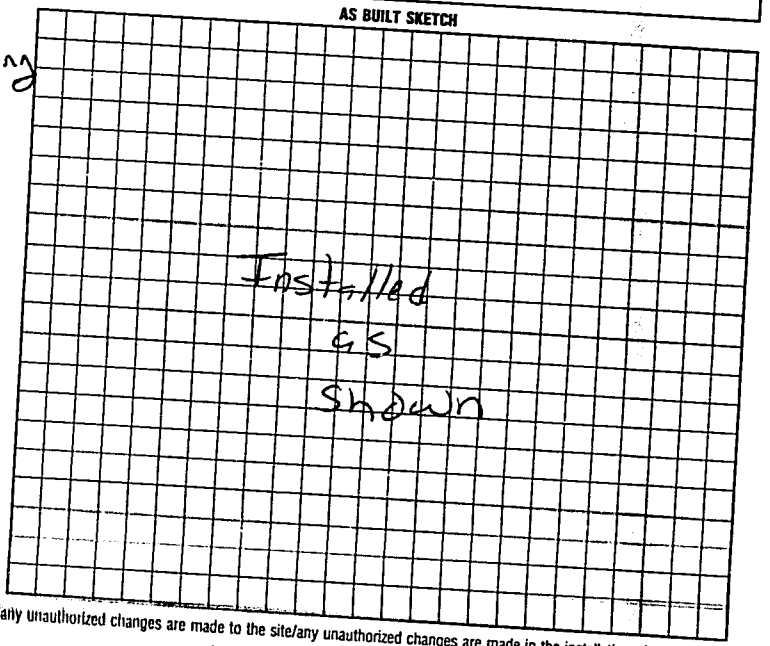

Old Mocksville

I understand that this permit can be suspended or revoked if any false information is supplied toward securing the permit/any unauthorized changes are made to the site/any unauthorized changes are made in the installation of the system. Improvement Permit is valid for 60 months from date of issuance

Signed. Chuck Fox

Improvement Permit by: Mary C Ott RS date 10-30-97

Existing System Inspection by: Heather Eaton for Mary C Ott RS date 10-30-97

Const. HEALTH DEPT. COPY: WHITE INSPECTION COPY (FINAL): GREEN OWNER COPY (FINAL) YELLOW

Installed by: Steve B Jordan

Certificate of Completion by:

Operation Permit by: Mary C Ott RS date 10-31-97

INSPECTION COPY (INITIAL) PINK OWNER COPY (INITIAL): GOLD