IREDELL COUNTY HEALTH DEPARTMENT

Statesville Phone TR 3-7271 Mooresville Phone NO 3-1271

PERMIT TO INSTALL SEPTIC TANK

Permit No. 47 Permit Date 5-11 1972

Owner MOORE Dairy Equipment Address STATESVILLE, NC.

Installed By Roy LENTZ Address STATESVILLE, NC.


Location of Property OLD MOCKSVILLE Rd. 2 Miles N of I-40

Tank		Capacity		Length of Lines		Fixtures	
Block	( )	1000	(✓)	225'	( )	No. of Baths	(2)
Precast	(✓)	1250	( )	250'	( )	Dishwasher	( )
		1500	( )	Other 238		Garbage Grdr.	( )
		Other				Other	

NOTIFY HEALTH DEPARTMENT AT LEAST EIGHT HOURS BEFORE TANK IS TO BE INSPECTED.

Final Inspection 5-11 1972 Approved (✓) Disapproved ( )

Remarks

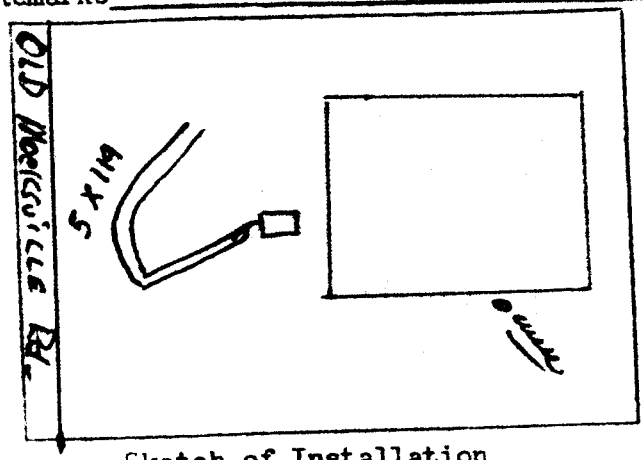

Sketch of Installation

Glenn Todd

Sanitarian