IREDELL COUNTY HEALTH DEPARTMENT

STATESVILLE 704-878-5305 MOORESVILLE 704-664-5281

IMPROVEMENT PERMIT / CERTIFICATE OF COMPLETION / OPERATION PERMIT / EXISTING SYSTEM INSPECTION

PROPERTY DESCRIPTION NO. _____ DATE 11-9-95 TAX MAP NO. _____ Watershed: ☐ Yes ☐ No

OWNER OR CONTRACTOR J. Coite Fox PHONE: Business _____ Home 872-~~1463~~ 3818

ADDRESS 594 Old Mocksville Rd

LOCATION 64E TL old Mocksville 2½ mi on Rt at Moo-Tel Sign

SUBDIVISION _____ BLOCK / SECTION _____ LOT _____ LOT AREA _____ SITE CLASS. _____ DESIGN FLOW _____ L.T.A.R. _____

Septic Tank: EX Gallons; STB _____ Date _____

Pump Tank: 1000 Gallons; PT 127 Date 8-9-95

Pump Make: Little Giant Model 9E Serial No. 5093

Nitrification Field: No Fields ___ Square Feet 900 Linear Feet 300

No Lines 3 Trench Width 36 Max Trench Bottom Depth 36" Gravel Depth N/A

☐ New System ☑ Repair System Type: I, II, III, IV, V, VI

System Description: _____

Repair System Description: Pump To Gravelless Chamber

Maintenance Agreement Required: ☐ Yes ☐ No

☑ House/Mod. Home No. Bedrooms 3

☐ Mobile Home No. Bathrooms 2

☐ Business No. Employees ___

☐ Other _____

☐ Slab ☐ Crawl Space ☑ Basement w/plumbing ☐ Basement wo/plumbing

Water Supply: ☑ Individual ☐ Community ☐ Public


.4 HP

Comments: Amount of line Equals 400' Conventional line

Comments: Inspected Drain Lines 11-17-95 JCM

Inspected Pump & manifold 11-22-95 JCM

INITIAL SITE SKETCH

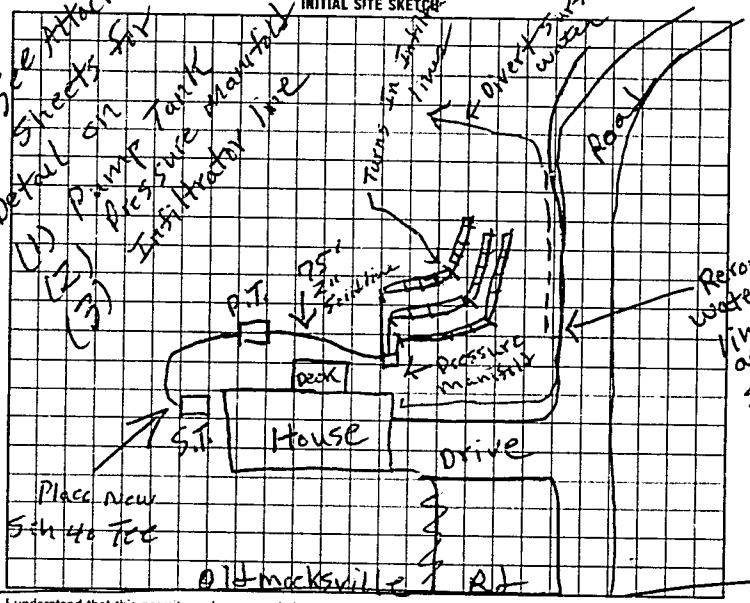

AS BUILT SKETCH

Alarm + wiring 12-8-95 JCM

I understand that this permit can be suspended or revoked if any false information is supplied toward securing the permit/any unauthorized changes are made to the site/any unauthorized changes are made in the installation of the system.

Signed: X J. Coite Fox

Improvement Permit by: R. C. Moore date 11-9-95

Authorization to Construct by: R. C. Moore date 11-9-95

Installed by: Harry Reep

Certificate of Completion by: _____ date _____

Operation Permit by: R. C. Moore date 12-8-95

HEALTH DEPT. COPY: WHITE INSPECTION COPY (FINAL): GREEN OWNER COPY (FINAL): YELLOW INSPECTION COPY (INITIAL): PINK OWNER COPY (INITIAL): GOLD

Authorization to Const. Expires 60 mos From date of issue

8 2 2 0 0