IREDELL COUNTY HEALTH DEPARTMENT

STATESVILLE 704-878-5305 MOORESVILLE 704-664-5281

IMPROVEMENT PERMIT / AUTHORIZATION TO CONSTRUCT / OPERATION PERMIT / EXISTING SYSTEM INSPECTION

PERMIT# 76597 PIN# 4756 76 3766 DATE 9-29-98

OWNER OR CONTRACTOR Tracey F. Smith PHONE: Business _____ Home 872 1963

ADDRESS 591 Old Mocksville Rd

LOCATION old mocksville Rd TL Jane Sowers on left Past Tracy Ln.

SUBDIVISION Grandview BLOCK / SECTION _____ LOT 4 LOT AREA 150'X200' SITE CLASS PS DESIGN FLOW 480 L.T.A.R. .35

Septic Tank: 1000 Gallons; STB 1012 Date 7-24-98
Pump Tank: _____ Gallons; PT _____ Date _____
Pump Make: _____ Model _____ Serial No. _____
Nitrification Field: No Fields 1 Square Feet 380 Linear Feet 460
No Lines 3 Trench Width 36" Max Trench Bottom Depth 36" Gravel Depth 12"

[X] New System [ ] Repair System Type: I, II, III, IV, V, VI
System Description: Conv. Gravity
Repair System Description: Gravity Chambers
Maintenance Agreement Required: [ ] Yes [X] No
[ ] Slab [X] Crawl Space [ ] Basement w/plumbing [ ] Basement wo/plumbing


[X] House/Mod. Home No. Bedrooms 4
[ ] Mobile Home No. Bathrooms 2½
[ ] Business No. Employees ____
[ ] Other _____

Water Supply: [ ] Individual [X] Public [ ] Community


Comments:/Conditions:

Comments:/Conditions:

INITIAL SITE SKETCH

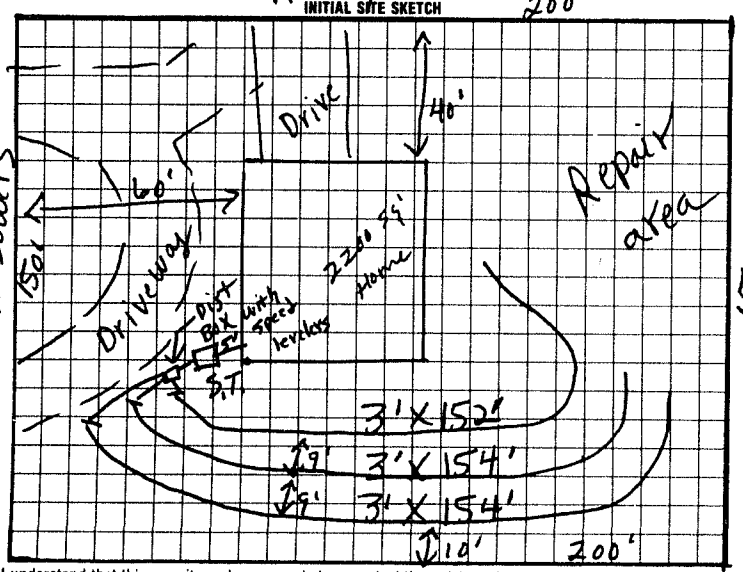

AS BUILT SKETCH

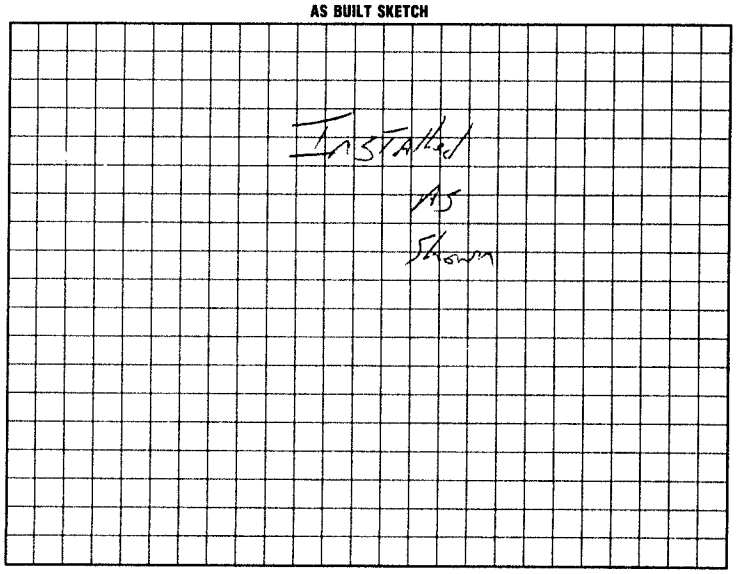

I understand that this permit can be suspended or revoked if any false information is supplied toward securing the permit/any unauthorized changes are made to the site/any unauthorized changes are made in the installation of the system. Improvement Permit with plat valid without expiration. Improvement Permit with site plan valid for sixty months. Authorization to Construct is valid for a period equal to that of Improvement Permit – not to exceed sixty months.

Signed: X _____ date _____ Installed by: Eddie Yountz & Son

Improvement Permit by: R. C. Moore date 9-29-98 Operation Permit by: _____ date Oct 8. 99

Authorization to Construct by: R. C. Moore date 9-29-98 Existing System Inspection by: _____ date _____

HEALTH DEPT. COPY: WHITE INSPECTION COPY (FINAL): GREEN OWNER COPY (FINAL): YELLOW INSPECTION COPY (INITIAL): PINK OWNER COPY (INITIAL): GOLD