4756-77-0158

IREDELL COUNTY HEALTH DEPARTMENT

STATESVILLE 704-878-5305 | MOORESVILLE 704-664-5281

6.2783

IMPROVEMENT PERMIT / CERTIFICATE OF COMPLETION / OPERATION PERMIT / EXISTING SYSTEM INSPECTION

PROPERTY DESCRIPTION NO. 23250 DATE 3-7-96 TAX MAP NO. 106-7-A-113 Watershed: Yes / No

OWNER OR CONTRACTOR Jesse F. Horne PHONE 873-2224

ADDRESS 254 Farmwood Drive Statesville, N.C.


LOCATION 21 N TR Jane Sewers TL Stone 115c Drive 2nd lot

SUBDIVISION Baymount SUBDIVISION 113 LOT AREA 1.13 ac LOT CLASS PS DESIGN FLOW 480 YEAR 75

Septic Tank	1000	101	8-25-94	New System / Repair System Type	Conv. Gravity	Water Supply: Individual / Community / Public
Pump Tank				Description	Pump to conv. line	
Pump Make				Mobile Home	No. Bedrooms 3 1/2	
Notification	1	150c	500		No. Occupants	
No. Lines	4	36"	36"	12"		

Comments:

INITIAL SITE SKETCH 268'

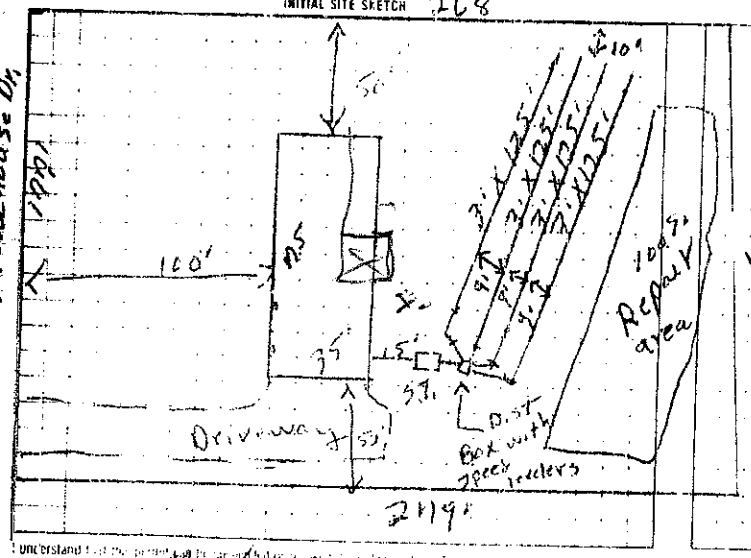

AS BUILT SKETCH

Same as initial sketch

I understand that the permit and any required improvements authorized under this permit do not guarantee the water supply or the proper operation of the system. Any changes in the plans or specifications of the system must be approved in writing by the Health Department before such changes are made or the permit becomes void.

Signed X

Improvement Permit by Authorization to Construct: R.C. Moore (HEALTH DEPT. COPY WHITE) date 3-1-96

R.C. Moore (INSPECTION COPY (FINAL) GREEN) date 3-1-96

Installed by Donald Lackey

Certificate of Completion by

Operation Permit by R.C. Moore (OWNER COPY (FINAL) YELLOW) date 11-21-96

The proposed deck conversion to sunroom does not appear to impact the existing septic area.

, R.S.
10 November 08

JAN. 5, 1989 6:57