62783

IREDELL COUNTY HEALTH DEPARTMENT

STATESVILLE 704-878-5305 MOORESVILLE 704-664-5281

IMPROVEMENT PERMIT / CERTIFICATE OF COMPLETION / OPERATION PERMIT / EXISTING SYSTEM INSPECTION

PROPERTY DESCRIPTION NO. 23250 DATE 3-7-96 TAX MAP NO. 106-7-A-113 Watershed: Yes / No

OWNER OR CONTRACTOR Jeff Horne PHONE Business Home 878-2224

ADDRESS 254 Farmwood Drive Statesville, N.C.

LOCATION 21 N TR Jane Sowers TL Stone House Drive 2nd lot Rt

SUBDIVISION Baymount SHA BLOCK / SECTION LOT 113 LOT AREA 1.13 acres SITE CLASS PS DESIGN FLOW 480 L.T.A.R. .32

Septic Tank: 1000 Gallons: STB 1012 Date 8-25-96 / New System Repair System Type: I II III IV V VI

Pump Tank: Gallons: PT Date System Description Conv. Gravity

Pump Make: Model Serial No Repair System Description Pump to conv. lines

Nitrification Field No. Fields 1 Square Feet 1500 Linear Feet 500 Maintenance Agreement Required Yes / No

No. Lines 4 Trench Width 36" Max. Trench Bottom Depth 36" Gravel Depth 12"

House/Mod. Home No. Bedrooms 4 3½

Mobile Home No. Bathrooms 2½

Business No. Employees

Other


Slab / Crawl Space Basement w/plumbing Basement wo/plumbing

Water Supply: Individual / Community / Public

Comments

Comments

INITIAL SITE SKETCH 268'

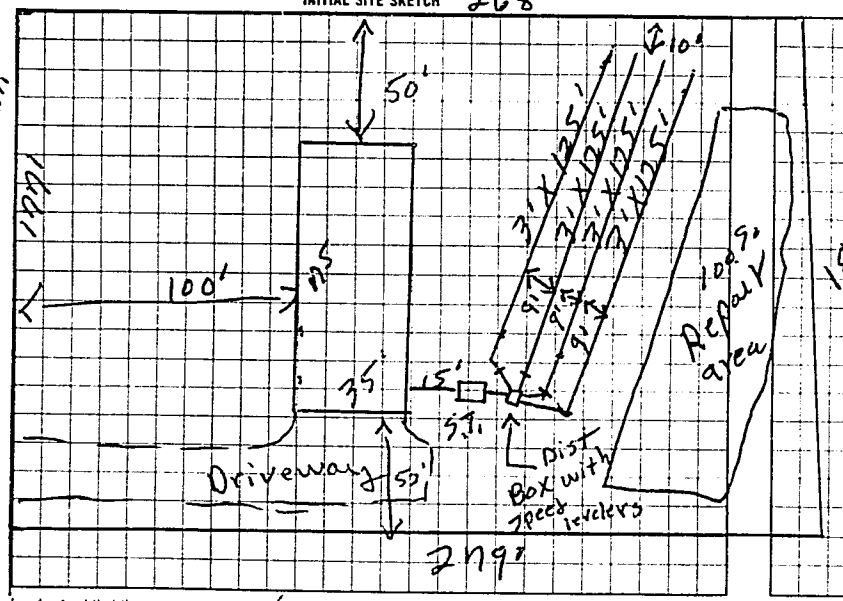

AS BUILT SKETCH

Same as initial sketch

I understand that this permit can be suspended or revoked if any false information is supplied toward securing the permit/any unauthorized changes are made to the site/any unauthorized changes are made in the installation of the system

Signed X

Improvement Permit by C. C. Moore date 3-7-96

Authorization Existing System Inspection by C. C. Moore date 3-7-96

Installed by Donald Lackey

Certificate of Completion by date

Operation Permit by C. C. Moore date 11-21-96

+ to County HEALTH DEPT COPY WHITE INSPECTION COPY (FINAL) GREEN OWNER COPY (FINAL) YELLOW INSPECTION COPY (INITIAL) PINK

Authorization to County EXPIRES 60 days from issue

8 8 8 0 0 0