IREDELL COUNTY HEALTH DEPARTMENT

STATESVILLE 704-878-5305 MOORESVILLE 704-664-5281

11:30 56190

IMPROVEMENT PERMIT / CERTIFICATE OF COMPLETION / OPERATION PERMIT / EXISTING SYSTEM INSPECTION

PROPERTY DESCRIPTION NO. 20856 DATE 4-18-95 TAX MAP NO. 106-7- A-120 Watershed: ☐ Yes ☑ No

OWNER OR CONTRACTOR Horne Building Co. PHONE: Business _____ Home _____

ADDRESS 254 Farmwood Dr. Sta

LOCATION 21N TR Jane Sowers TL Stone House Dr, 3rd lot Rt

SUBDIVISION Paymount BLOCK / SECTION Stone House Section LOT 112 LOT AREA 1 acre SITE CLASS. PS DESIGN FLOW 480 L.T.A.R. .33

Septic Tank: 1000 Gallons; STB 1012 Date 10-3-95

Pump Tank: _____ Gallons; PT _____ Date _____

Pump Make: _____ Model _____ Serial No. _____

Nitrification Field: No Fields 1 Square Feet 1380 Linear Feet 460

No Lines 3 Trench Width 36" Max Trench Bottom Depth 36" Gravel Depth 12"

☑ New System ☐ Repair System Type: I (II) III, IV, V, VI

System Description: conv. Gravity

Repair System Description: " "

Maintenance Agreement Required: ☐ Yes ☐ No

☑ House/Mod. Home No. Bedrooms 4

☐ Mobile Home No. Bathrooms 2½

☐ Business No. Employees ____

☐ Other _____


☐ Slab ☑ Crawl Space ☐ Basement w/plumbing ☐ Basement wo/plumbing

Water Supply: ☐ Individual ☐ Community ☑ Public


Comments: use D. Box with speed levelers

Comments:

INITIAL SITE SKETCH

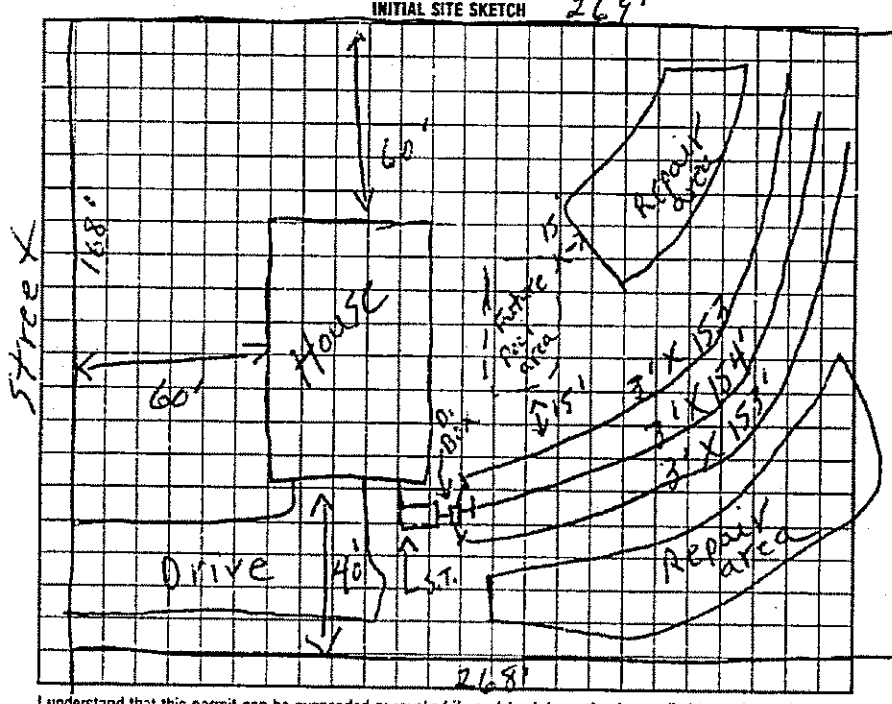

AS BUILT SKETCH

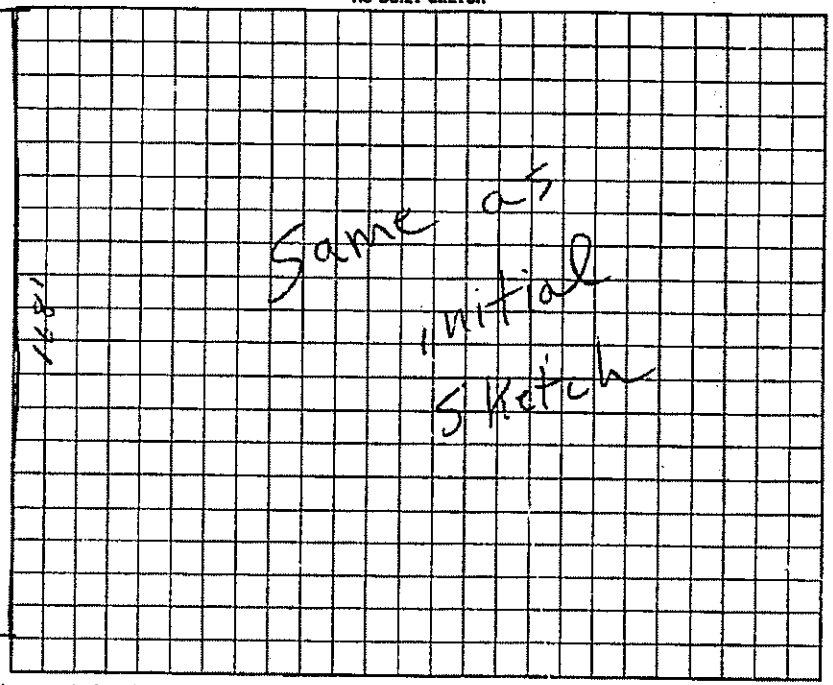

I understand that this permit can be suspended or revoked if any false information is supplied toward securing the permit/any unauthorized changes are made to the site/any unauthorized changes are made in the installation of the system. Improvement Permit is valid for 60 months from date of issuance.

Signed: X Jeffrey Horne

Improvement Permit by: P. C. Moore date 4-18-95

Existing System Inspection by: _____ date _____

Installed by: Donald Lackey

Certificate of Completion by: [redacted] date _____

Operation Permit by: P. C. Moore date 12-21-95

HEALTH DEPT. COPY: WHITE INSPECTION COPY (FINAL): GREEN OWNER COPY (FINAL): YELLOW INSPECTION COPY (INITIAL): PINK OWNER COPY (INITIAL): GOLD

0007 12