IREDELL COUNTY HEALTH DEPARTMENT - *ENVIRONMENTAL HEALTH* ☐ STATESVILLE OFFICE 704-878-5305 ☐ MOORESVILLE OFFICE 704-664-5281

IMPROVEMENT PERMIT / AUTHORIZATION TO CONSTRUCT / OPERATION PERMIT / EXISTING SYSTEM INSPECTION

PERMIT # Repair PIN # 4756-77-9430 DATE 16 June 2011

OWNER Patricia Cranlocks APPLICANT: Fred Maine PHONE: Home/Cell # (704) 876-6239 Business #

SITE ADDRESS 130 Country Dr. Stat. OWNER / APPLICANT ADDRESS

SITE DIRECTIONS Hwy 21 N TR Jane Downs TL Country Dr. 3rd HOUSE on Rt.

SUBDIVISION Baymount Meadows BLOCK / SECTION LOT # 22 LOT AREA 1 Ac. DESIGN FLOW 480 g/d L.T.A.R. N/A

Septic Tank 1000g Gallons: STB 160 Date 3-7-11
Pump Tank Gallons: P T Date
Pump Make Model Serial #
No. Nitrification Fields: NR No. Lines NR Linear Feet NR
Trench Width NA Max. Trench Bottom Depth NA Gravel Depth NA

☐ New System ☑ Repair ☐ Expansion System Type I (II) III IV V VI
System Description: Exist. Conventional Gravel Trench
Repair System Description: Tank Replacement.
Maintenance Agreement Required ☐ YES ☑ NO
☐ GRAVITY ☐ PRESSURE


☑ Residence No. Bedrooms 4
☐ Business No. Persons
☐ Other No. Employees
☐ Slab ☐ Crawl Space
☑ Basement w/plumbing ☐ Basement w/o plumbing

Water Supply: ☐ Private ☑ Public ☐ Community


Comments / Conditions * Replace with new 1000g ST. Properly abandon old septic TANK.

RED POLYLOK FILTER INSTALLED SEPTIC TANK WITH RISERS & MARKER INSTALLED

INITIAL SITE SKETCH

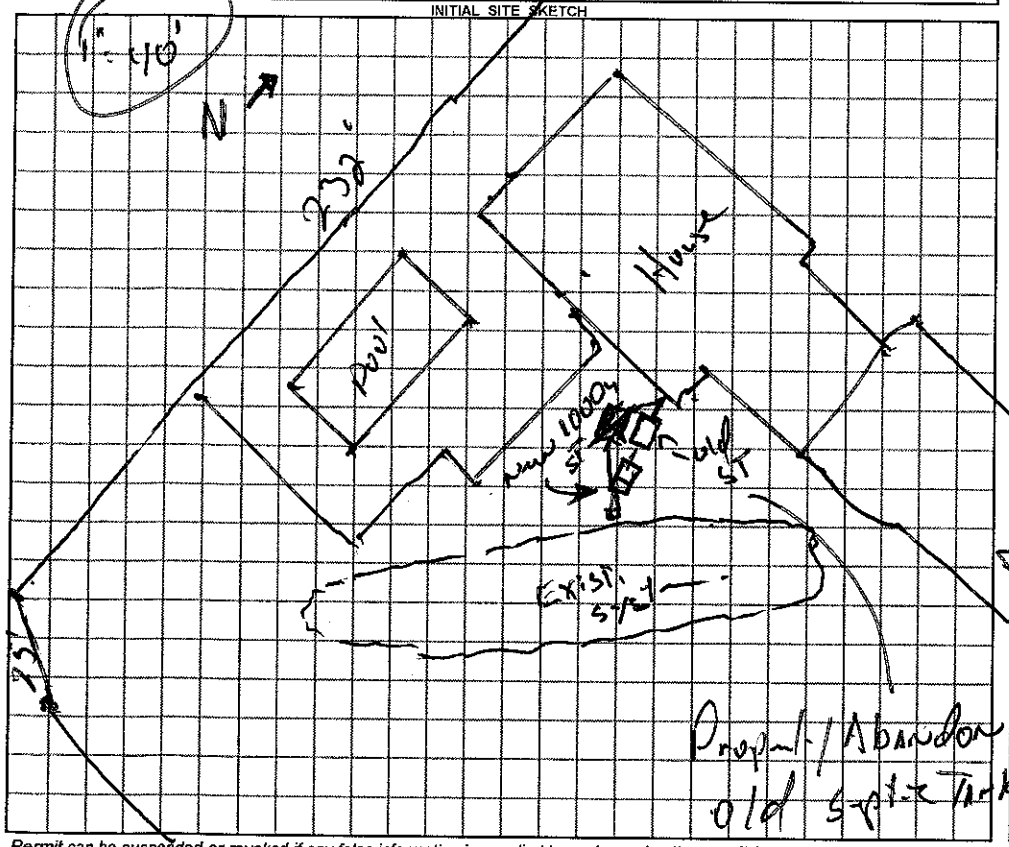

AS BUILT SKETCH

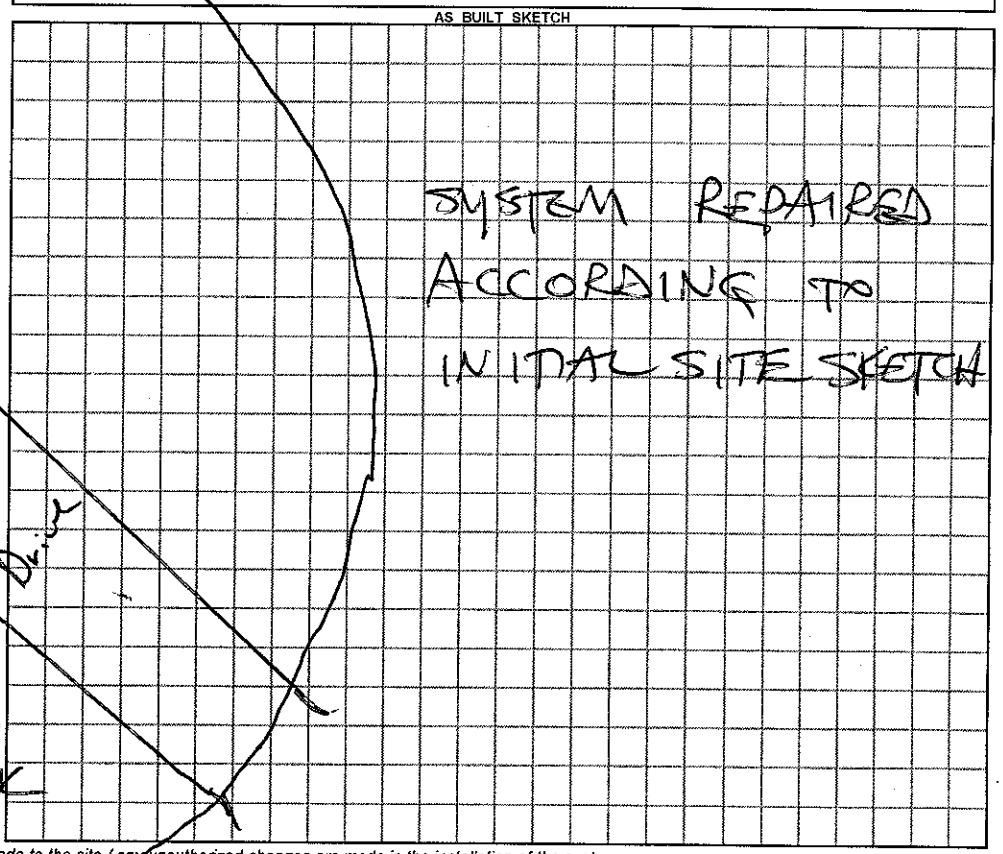

Permit can be suspended or revoked if any false information is supplied toward securing the permit / any unauthorized changes are made to the site / any unauthorized changes are made in the installation of the system.

☐ ***IMPROVEMENT PERMIT*** with plat valid without expiration. ☐ ***IMPROVEMENT PERMIT*** with plat valid without expiration. site plan valid 60 mo. ☑ ***AUTHORIZATION TO CONSTRUCT*** valid for period equal to IMPROVEMENT PERMIT--not to exceed 60 mo.

Owner / Applicant Signature: Fred Maine Date 6/17/2011 Installed by: DEREK BARNES

IMPROVEMENT PERMIT by: REHS Date

AUTHORIZATION TO CONSTRUCT by: REHS Date 16 June 11

OPERATION PERMIT by: STEVE HENDRICK REHS Date 6-17-11

Existing System Inspected by: REHS Date

YOU SHOULD CONTACT A LOCATOR SERVICE PRIOR TO ANY EXCAVATION

White Copy -- Environmental Health YELLOW COPY (Final) Owner / Applicant PINK COPY (Initial) Owner / Applicant