IREDELL COUNTY HEALTH DEPARTMENT - *ENVIRONMENTAL HEALTH* ☐ STATESVILLE OFFICE 704-878-5305 ☐ MOORESVILLE OFFICE 704-664-5281

IMPROVEMENT PERMIT / AUTHORIZATION TO CONSTRUCT / OPERATION PERMIT / EXISTING SYSTEM INSPECTION

PERMIT # Repair PIN # 4756-84-3665 DATE 16 June 2011

OWNER Koopman Dairies, Inc. APPLICANT: PHONE: Home/Cell # 601/682-8161 Business #

SITE ADDRESS 122 Buttke Dr. Stat. OWNER / APPLICANT ADDRESS

SITE DIRECTIONS Old Mocksville Rd. Turn Buttke Rd. Go to End. on Rt.

SUBDIVISION BLOCK / SECTION LOT # LOT AREA 31.78 Ac. DESIGN FLOW 360 gpd L.T.A.R. 0.3 gpd/sf

Septic Tank Exist. Gallons: STB Date

Pump Tank Gallons: P T Date

Pump Make Model Serial #

No. Nitrification Fields: 1 No. Lines 3 Linear Feet 300

Trench Width 36" Max. Trench Bottom Depth 36" Gravel Depth NA

☐ New System ☑ Repair ☐ Expansion System Type I II (III) IV V VI

System Description:

Repair System Description: 25% Reduction

Maintenance Agreement Required ☐ YES ☑ NO

☑ GRAVITY ☐ PRESSURE

☑ Residence No. Bedrooms 3

☐ Business No. Persons

☐ Other No. Employees

☐ Slab ☑ Crawl Space


☐ Basement w/plumbing ☐ Basement w/o plumbing

Water Supply: ☐ Private ☑ Public ☐ Community


Comments / Conditions: Replace Drop-boxes / Repair Risers on Existing Septic Tank.

* Septic System shall be repaired within 30 days from the date of this permit. NOV has been issued.

INITIAL SITE SKETCH

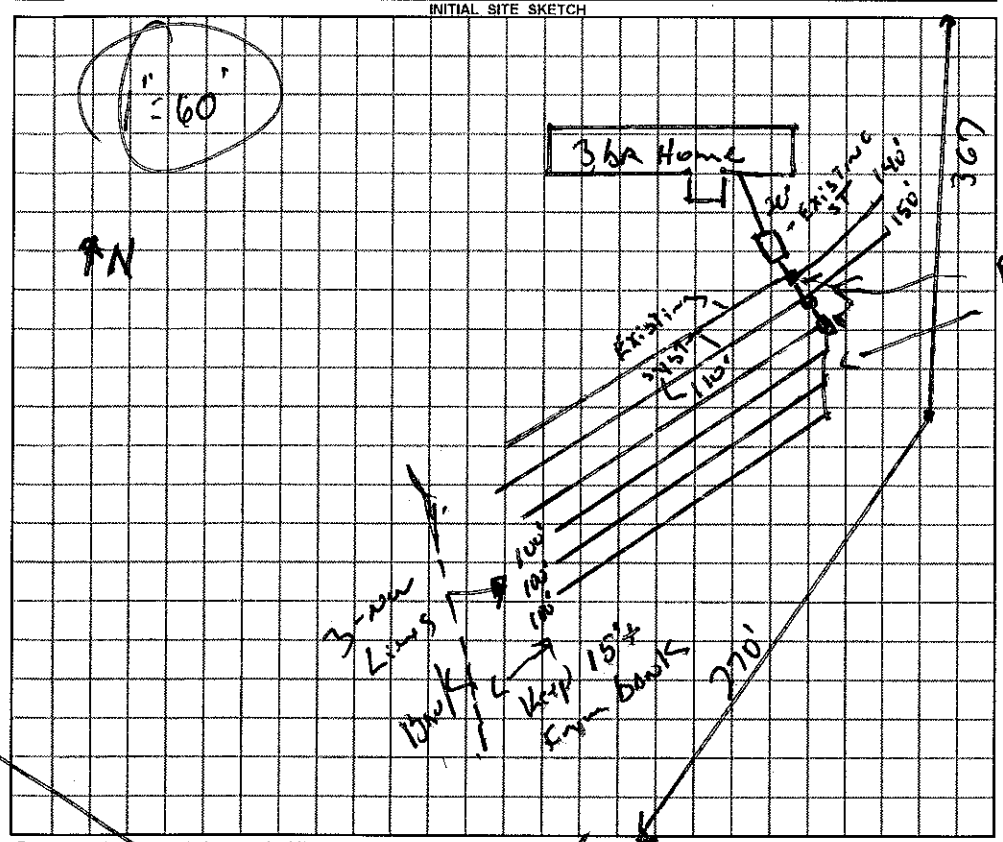

AS BUILT SKETCH

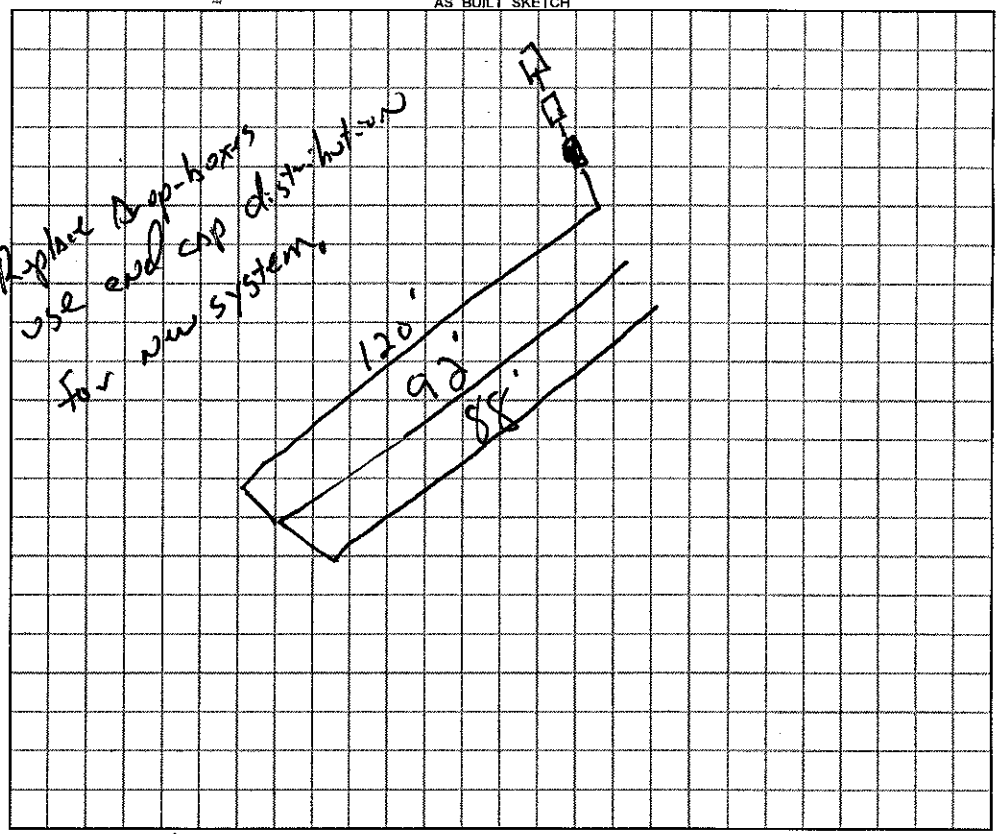

Permit can be suspended or revoked if any false information is supplied toward securing the permit / any unauthorized changes are made to the site / any unauthorized changes are made in the installation of the system.

☐ *IMPROVEMENT PERMIT* with plat valid without expiration. ☑ *IMPROVEMENT PERMIT* with ~~plat valid without expiration.~~ site plan valid 60 mo. ☑ *AUTHORIZATION TO CONSTRUCT* valid for period equal to IMPROVEMENT PERMIT--not to exceed 60 mo.

Owner / Applicant Signature: Date 6-21-11

IMPROVEMENT PERMIT by: REHS Date 16 June 11

AUTHORIZATION TO CONSTRUCT by: REHS Date 16 June 11

YOU SHOULD CONTACT A LOCATOR SERVICE PRIOR TO ANY EXCAVATION

Installed by: A-1 Backhoe

OPERATION PERMIT by: REHS Date 22 June 11

Existing System Inspected by: REHS Date

White Copy -- Environmental Health YELLOW COPY (Final) Owner / Applicant PINK COPY (Initial) Owner / Applicant