IREDELL COUNTY HEALTH DEPARTMENT - *ENVIRONMENTAL HEALTH* ☐ STATESVILLE OFFICE 704-878-5305 ☐ MOORESVILLE OFFICE 704-664-5281

IMPROVEMENT PERMIT / AUTHORIZATION TO CONSTRUCT / OPERATION PERMIT / EXISTING SYSTEM INSPECTION @

PERMIT # 168795 PIN # 4756-84-3665 DATE 19 October 11

OWNER Koopman Dairies APPLICANT: Arol Koopman PHONE: Home/Cell # (704) 929-0659 Business #

SITE ADDRESS 108 Buttke Dr. Statesville OWNER / APPLICANT ADDRESS

SITE DIRECTIONS Intersect. of Buttke Dr. and Old Mocksville Hy

SUBDIVISION BLOCK / SECTION LOT # LOT AREA 31.78ac. DESIGN FLOW 300gpd L.T.A.R. ex.


Septic Tank ex.	Gallons: STB	Date	☐ New System	☐ Repair	☐ Expansion System	Type I ☒ II III IV V VI	☑ Residence
Pump Tank	Gallons: P T	Date	System Description: Gravel / trench				☐ Business
Pump Make	Model	Serial #	Repair System Description:				☐ Other
No. Nitrification Fields: ex	No. Lines ex	Linear Feet ex	Maintenance Agreement Required ☐ YES ☑ NO				☐ Slab
Trench Width ex	Max. Trench Bottom Depth ex	Gravel Depth ex	☑ GRAVITY ☐ PRESSURE				☐ Basement w/plumbing

☑ Residence No. Bedrooms 3
☐ Business No. Persons
☐ Other No. Employees
☐ Slab ☑ Crawl Space
☐ Basement w/plumbing ☐ Basement w/o plumbing

Water Supply: ☐ Private ☑ Public ☐ Community

Comments / Conditions

INITIAL SITE SKETCH

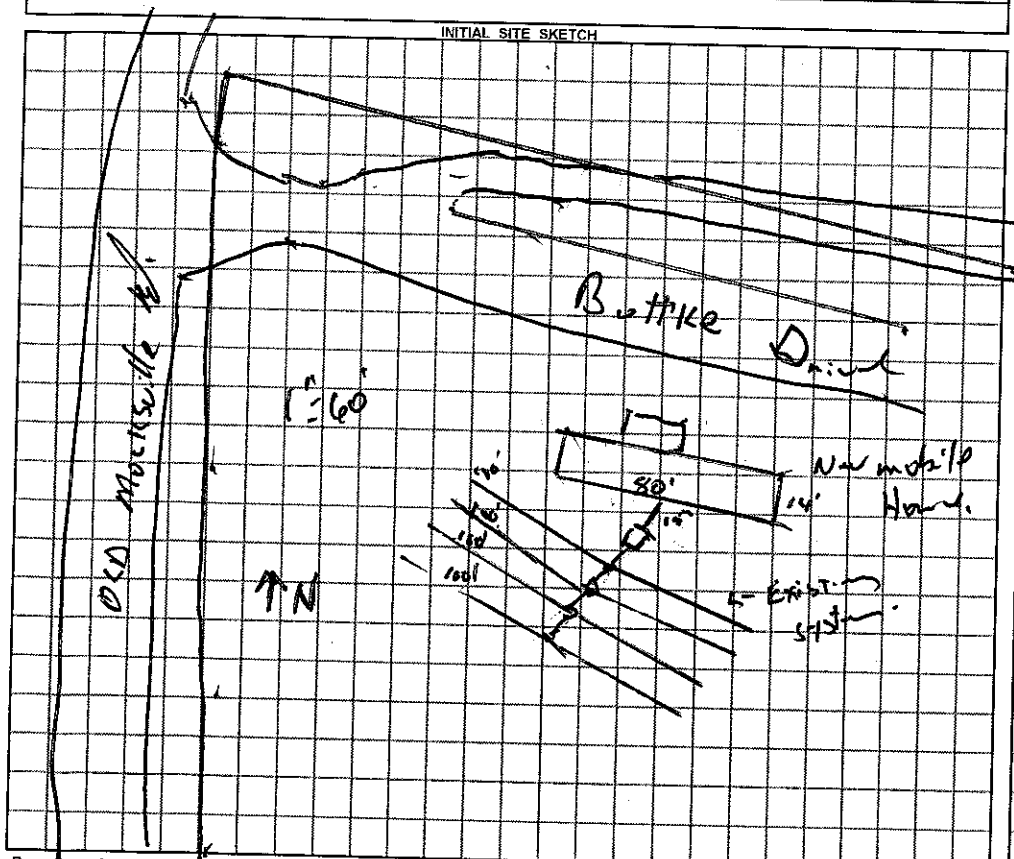

AS BUILT SKETCH

Permit can be suspended or revoked if any false information is supplied toward securing the permit / any unauthorized changes are made to the site / any unauthorized changes are made in the installation of the system.

☐ ***IMPROVEMENT PERMIT*** with plat valid without expiration. ☐ ***IMPROVEMENT PERMIT*** with ~~plat valid without expiration.~~ site plan valid 60 mo. ☐ ***AUTHORIZATION TO CONSTRUCT*** valid for period equal to IMPROVEMENT PERMIT--not to exceed 60 mo.

Owner / Applicant Signature: Arol Koopman Date 10-24-11 Installed by:

IMPROVEMENT PERMIT by: REHS Date

AUTHORIZATION TO CONSTRUCT by: REHS Date

OPERATION PERMIT by: REHS Date

Existing System Inspected by: REHS Date 19 Oct. 11

YOU SHOULD CONTACT A LOCATOR SERVICE PRIOR TO ANY EXCAVATION

White Copy – Environmental Health YELLOW COPY (Final) Owner / Applicant PINK COPY (Initial) Owner / Applicant